

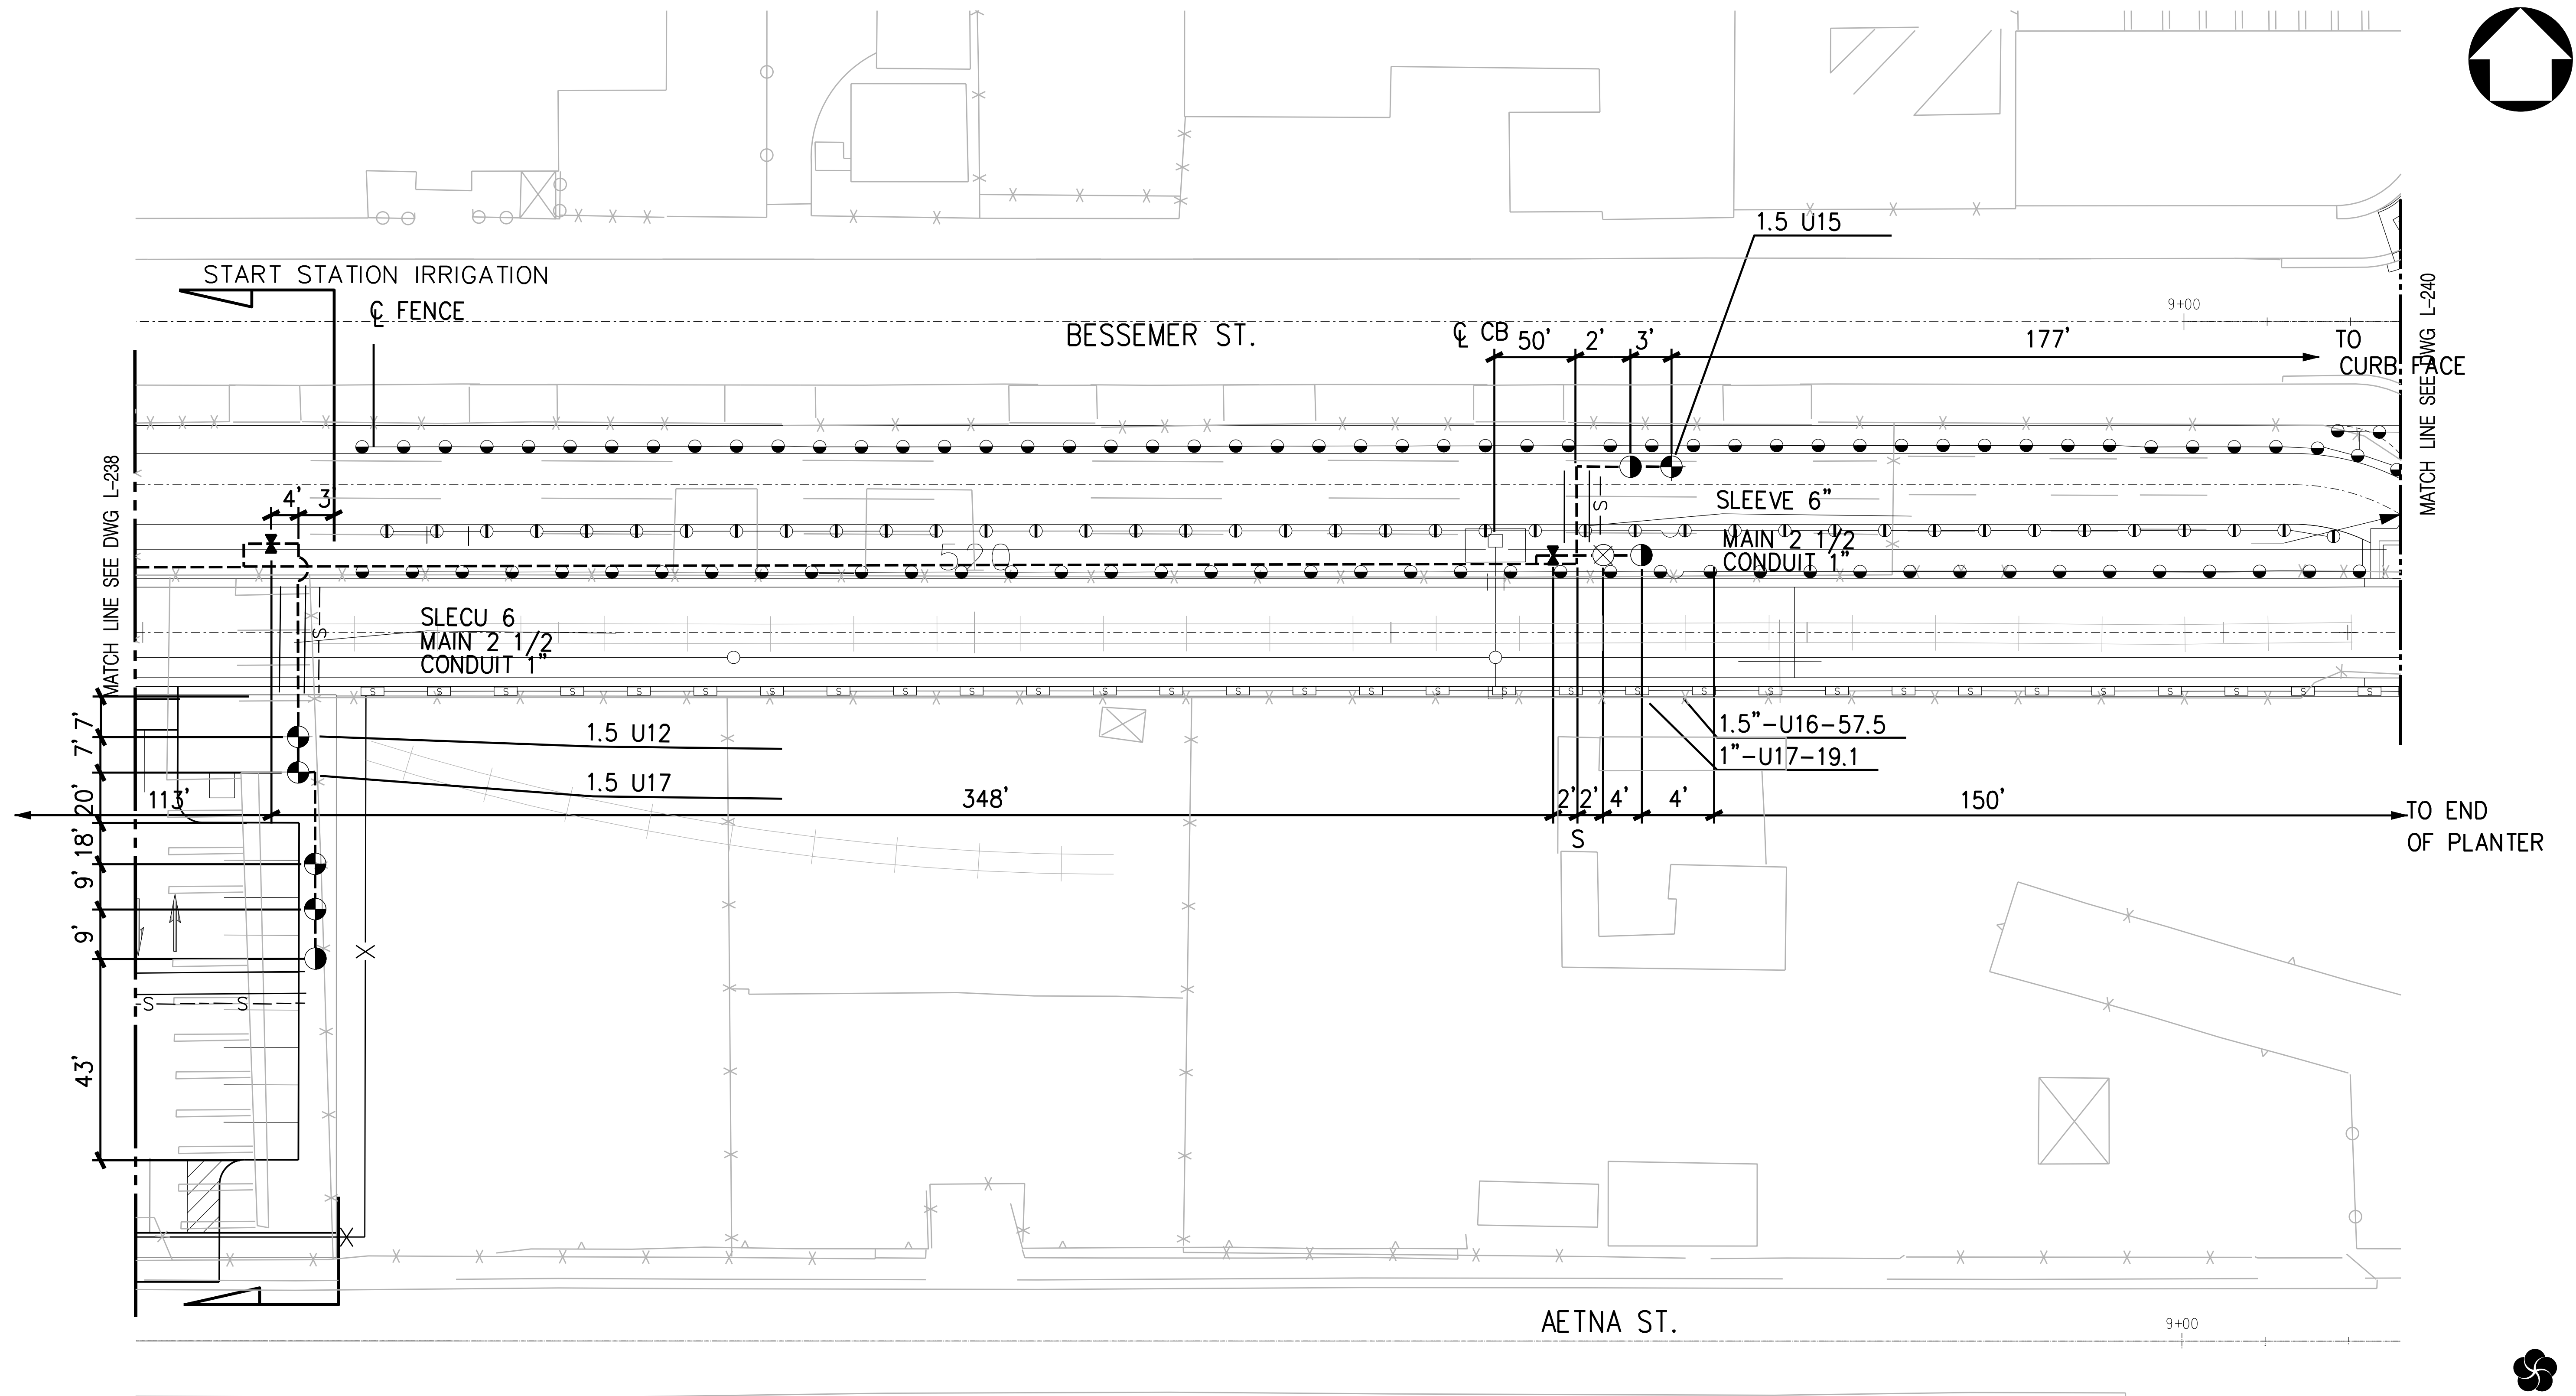


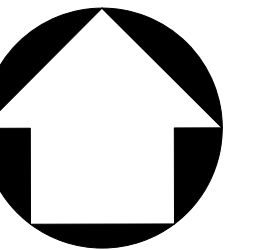

ISSUE FOR CONSTRUCTION

REV	DATE	BY	APP	REG NO	EXPIRES	SEAL HOLDER	DESCRIPTION
0	5/23/05						AS-BUILTS
							ISSUE FOR CONSTRUCTION

DESIGNED BY	MG
DRAWN BY	T&P
CHECKED BY	KLS
IN CHARGE	DT
DATE	5/23/2005

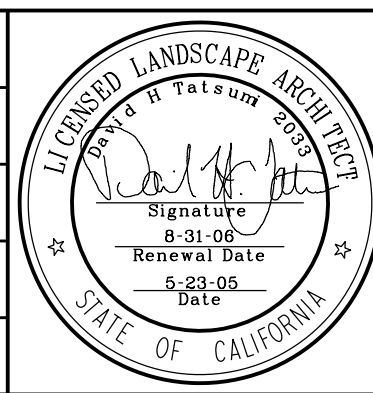

LOS ANGELES COUNTY METROPOLITAN TRANSPORTATION AUTHORITY
SAN FERNANDO VALLEY EAST-WEST BRT PROJECT

TATSUMI AND PARTNERS, INC.
LANDSCAPE ARCHITECTURE • PLANNING • DESIGN
5 CORPORATE PARK, SUITE 200
BURNING WOOD, CA 91306-5866
949/250-9890 FAX 949/250-9891

SUBMITTED BY: DATE: _____
DAVID H. TATSUMI

NORTH HOLLYWOOD TO WARNER CENTER IRRIGATION PLAN
STA 518+00 TO STA 523+50
SHEET 97 OF 136

CONTRACT NO. C0675
DRAWING NO. L-239
SCALE 1"=20'
SHEET NO.

CONTRACT NO.	C0675
DRAWING NO.	L-239
SCALE	1"=20'
SHEET NO.	

Mike G