
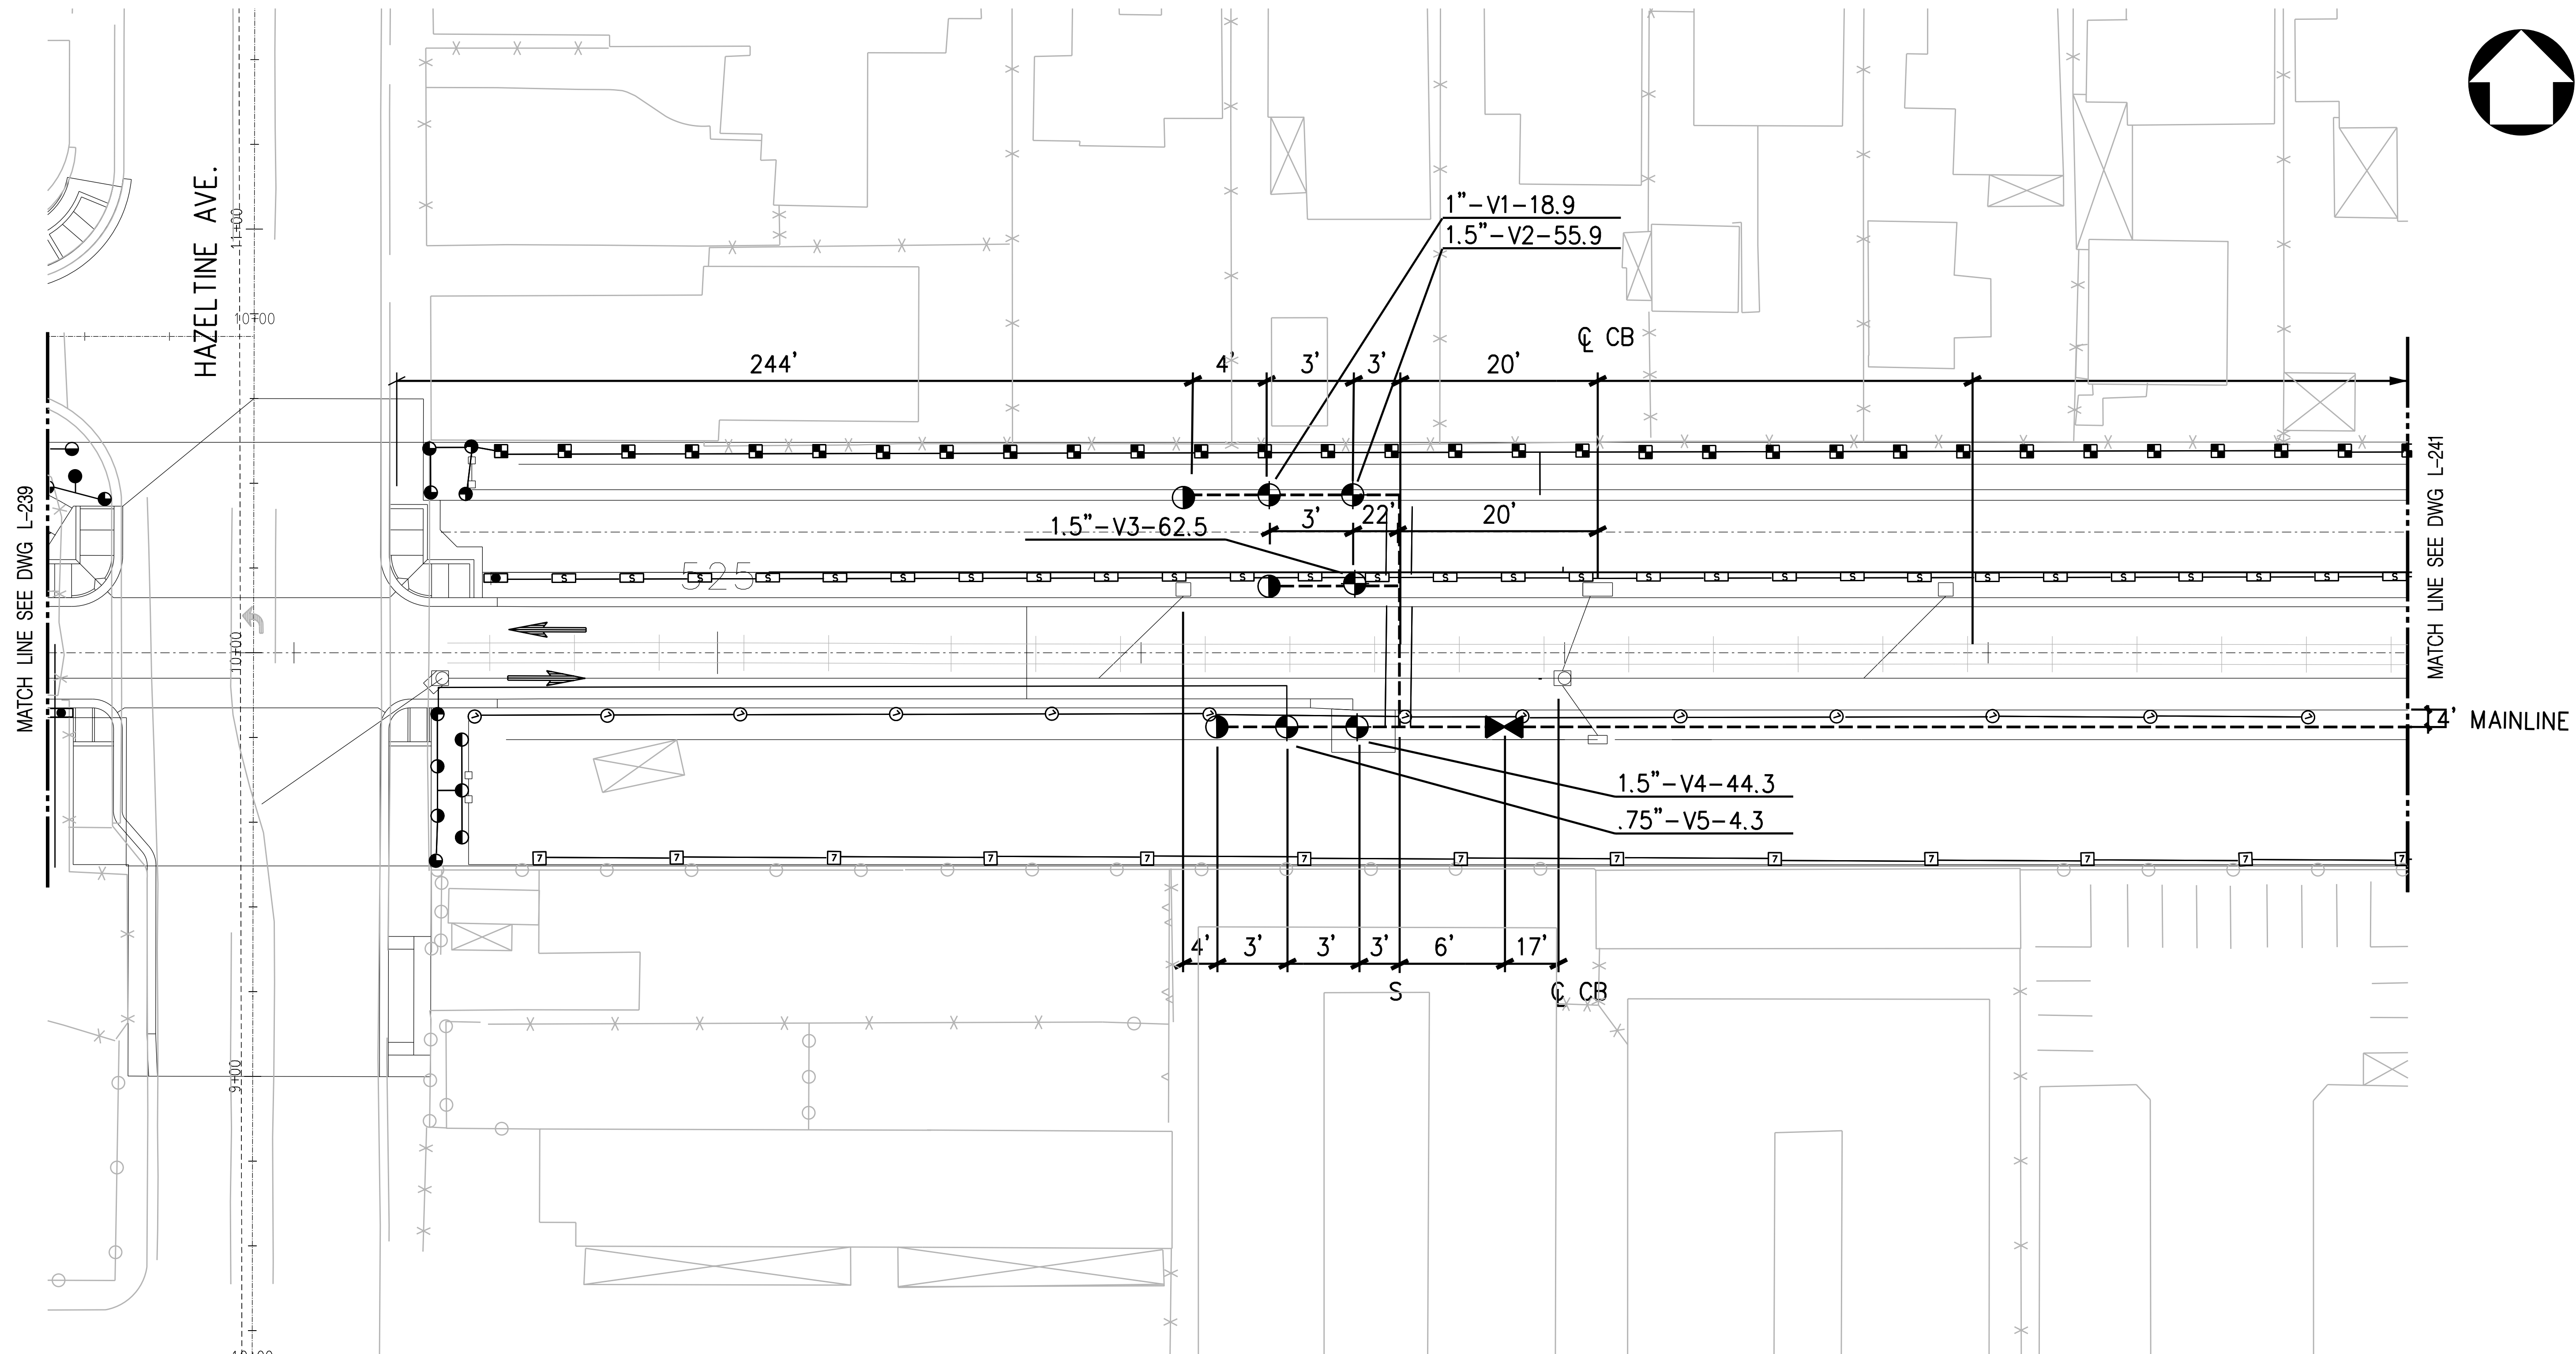
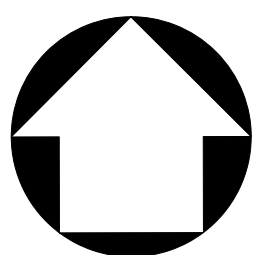


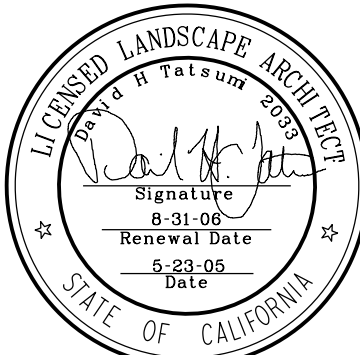

ISSUE FOR CONSTRUCTION

								DESIGNED BY MG			 LOS ANGELES COUNTY METROPOLITAN TRANSPORTATION AUTHORITY SAN FERNANDO VALLEY EAST-WEST BRT PROJECT TATSUMI AND PARTNERS, INC. LANDSCAPE ARCHITECTURE • PLANNING • DESIGN 5 CORPORATE PARK, SUITE 200 BURNING WOOD, CA 91306-5866 949/250-9890 FAX 949/250-9891		NORTH HOLLYWOOD TO WARNER CENTER IRRIGATION PLAN STA 523+50 TO STA 529+00 SHEET 98 OF 136		CONTRACT NO C0675 DRAWING NO L- 240 REV 0 SCALE 1"=20' SHEET NO	
								DRAWN BY T&P								
								CHECKED BY KLS								
								IN CHARGE DT								
REV	DATE	BY	APP	REG NO	EXPIRES	SEAL HOLDER	DESCRIPTION	DATE 5/23/2005								
0	5/23/05						AS-BUILTS									
							ISSUE FOR CONSTRUCTION									