


HAZELTINE AVE.

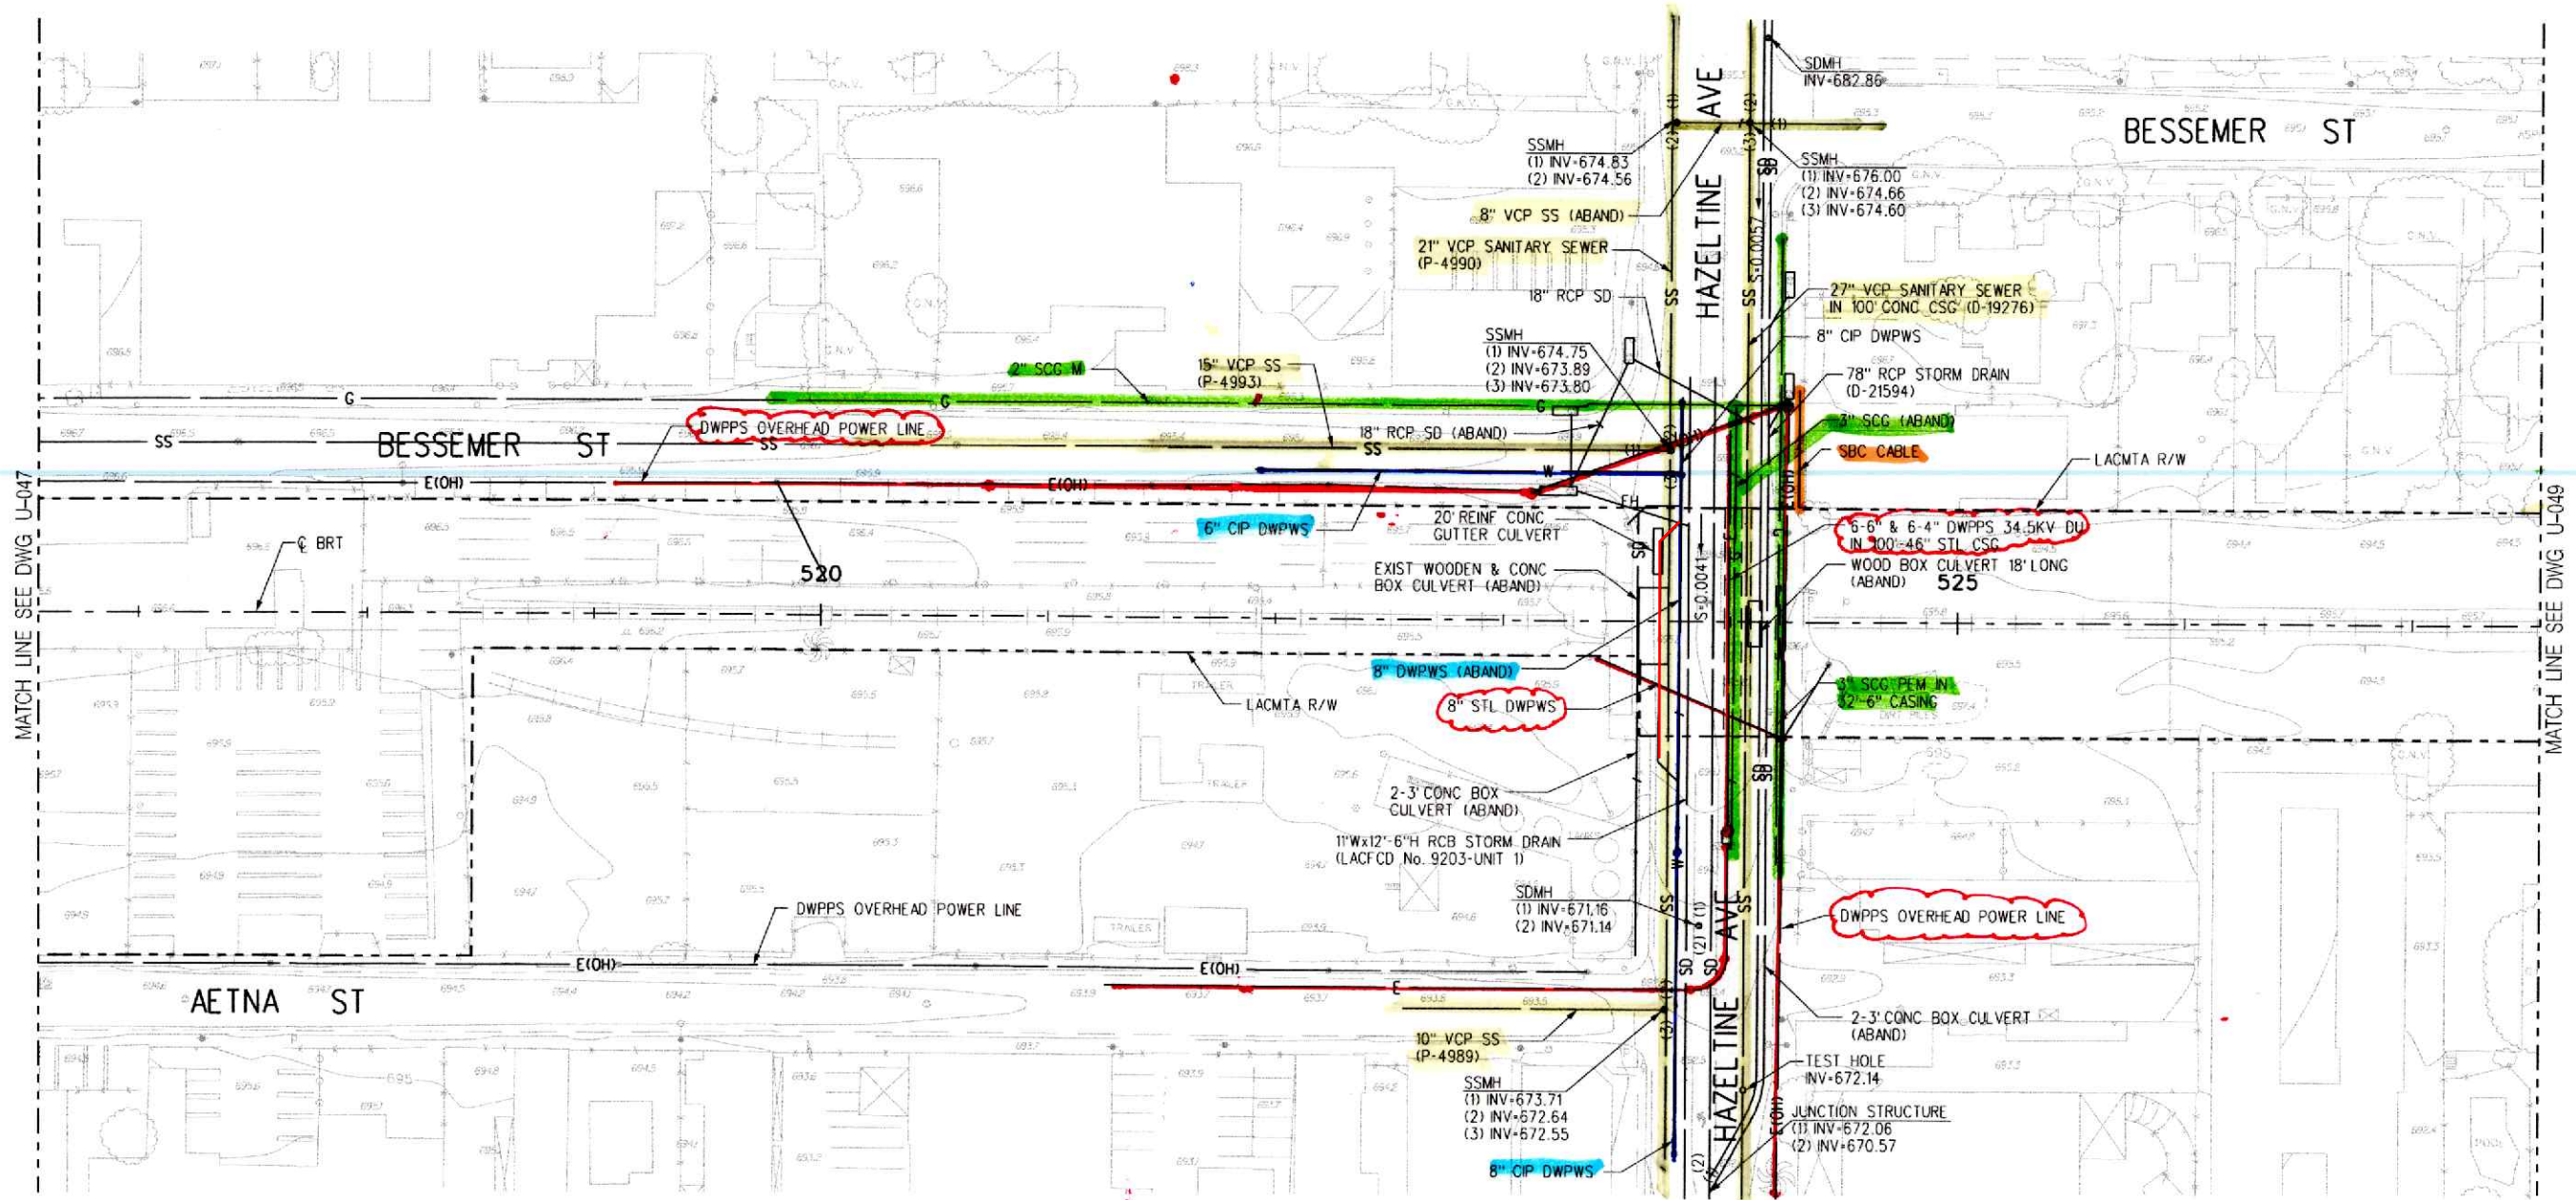

NOTES:
1. MANHOLE INVERT ELEVATIONS
BASED ON NGVD 29
2. UNLESS OTHERWISE NOTED,
ALL UTILITIES ARE LOW RISK
3. UTILITIES ARE BASED ON AVAILABLE
AS-BUILT AND POTHOLE DATA
UTILITIES SHALL BE FIELD VERIFIED
BY CONTRACTOR PRIOR TO CONSTRUCTION.


—e— (electric)
—w— (water)
—ss— (sewer)
—g— (gas)
—t— (telecom)



NOT FOR CONSTRUCTION

REV	DATE	BY	APP	REG NO	EXPIRES	SEAL HOLDER	DESCRIPTION
0	4/06/04	AKJ	BEJ	C42345	3/31/06	ARVIND K. JOSHI	ISSUED FOR CONSTRUCTION

DESIGNED BY
S. YOUSEFIAN
DRAWN BY
M. CUTTER
CHECKED BY
D. CONYERS
IN CHARGE
A. JOSHI
DATE
4/06/04

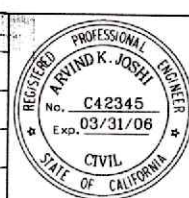

LOS ANGELES COUNTY METROPOLITAN TRANSPORTATION AUTHORITY
SAN FERNANDO VALLEY EAST-WEST BRT PROJECT

Washington Group International
WASHINGTON GROUP INTERNATIONAL, INC.
6805 SEPULVEDA BLVD., SUITE 500
VAN NUYS, CA 91411

SHIMMICK
OBAYASHI, JV
5805 SEPULVEDA BLVD., SUITE 500
VAN NUYS, CA 91411

NORTH HOLLYWOOD TO
WARNER CENTER
UTILITIES
SHEET 45 OF 65

CONTRACT NO	C0675
DRAWING NO	U-048
SCALE	HORIZ. 1"=40'
SHEET NO	0