



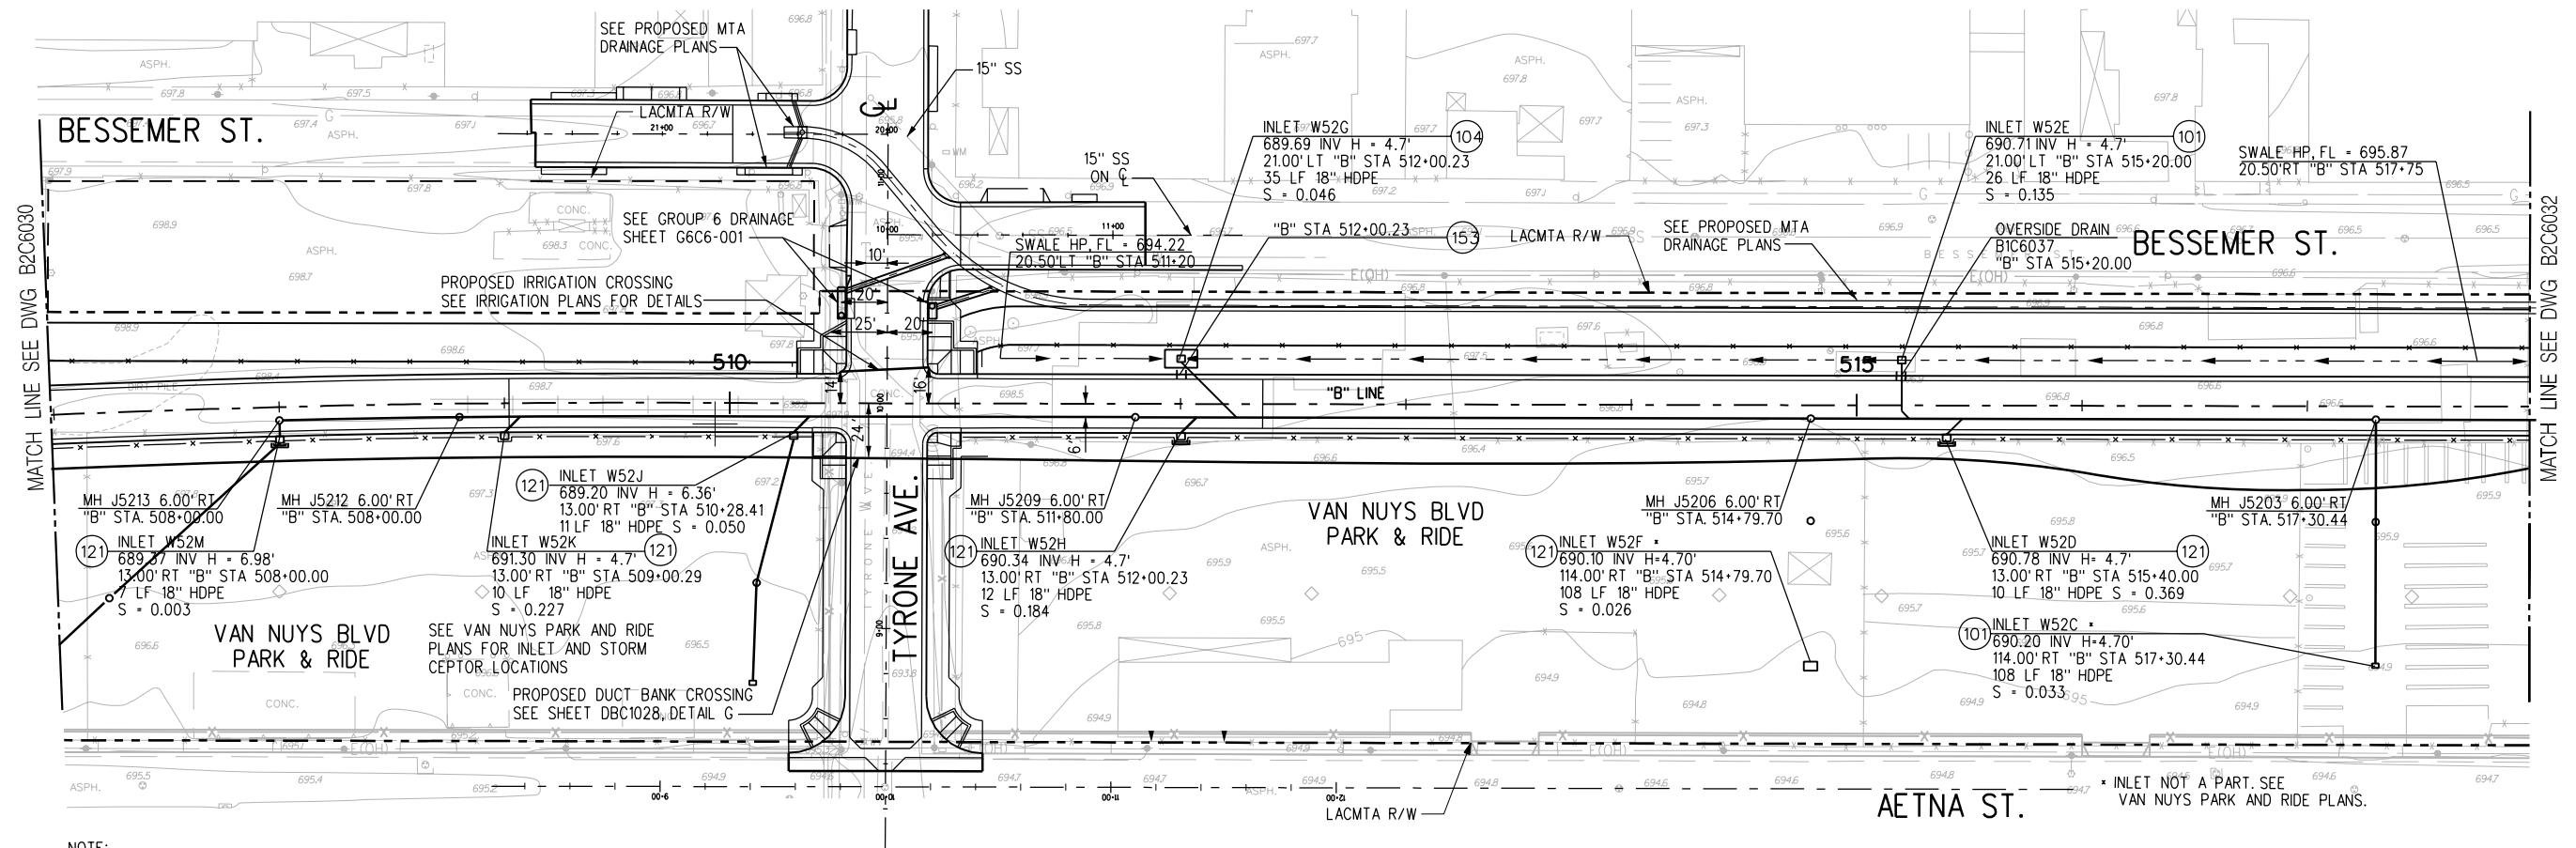

NOTE:
FOR SWALE INFORMATION
SEE SHEET B2C6024

PLAN

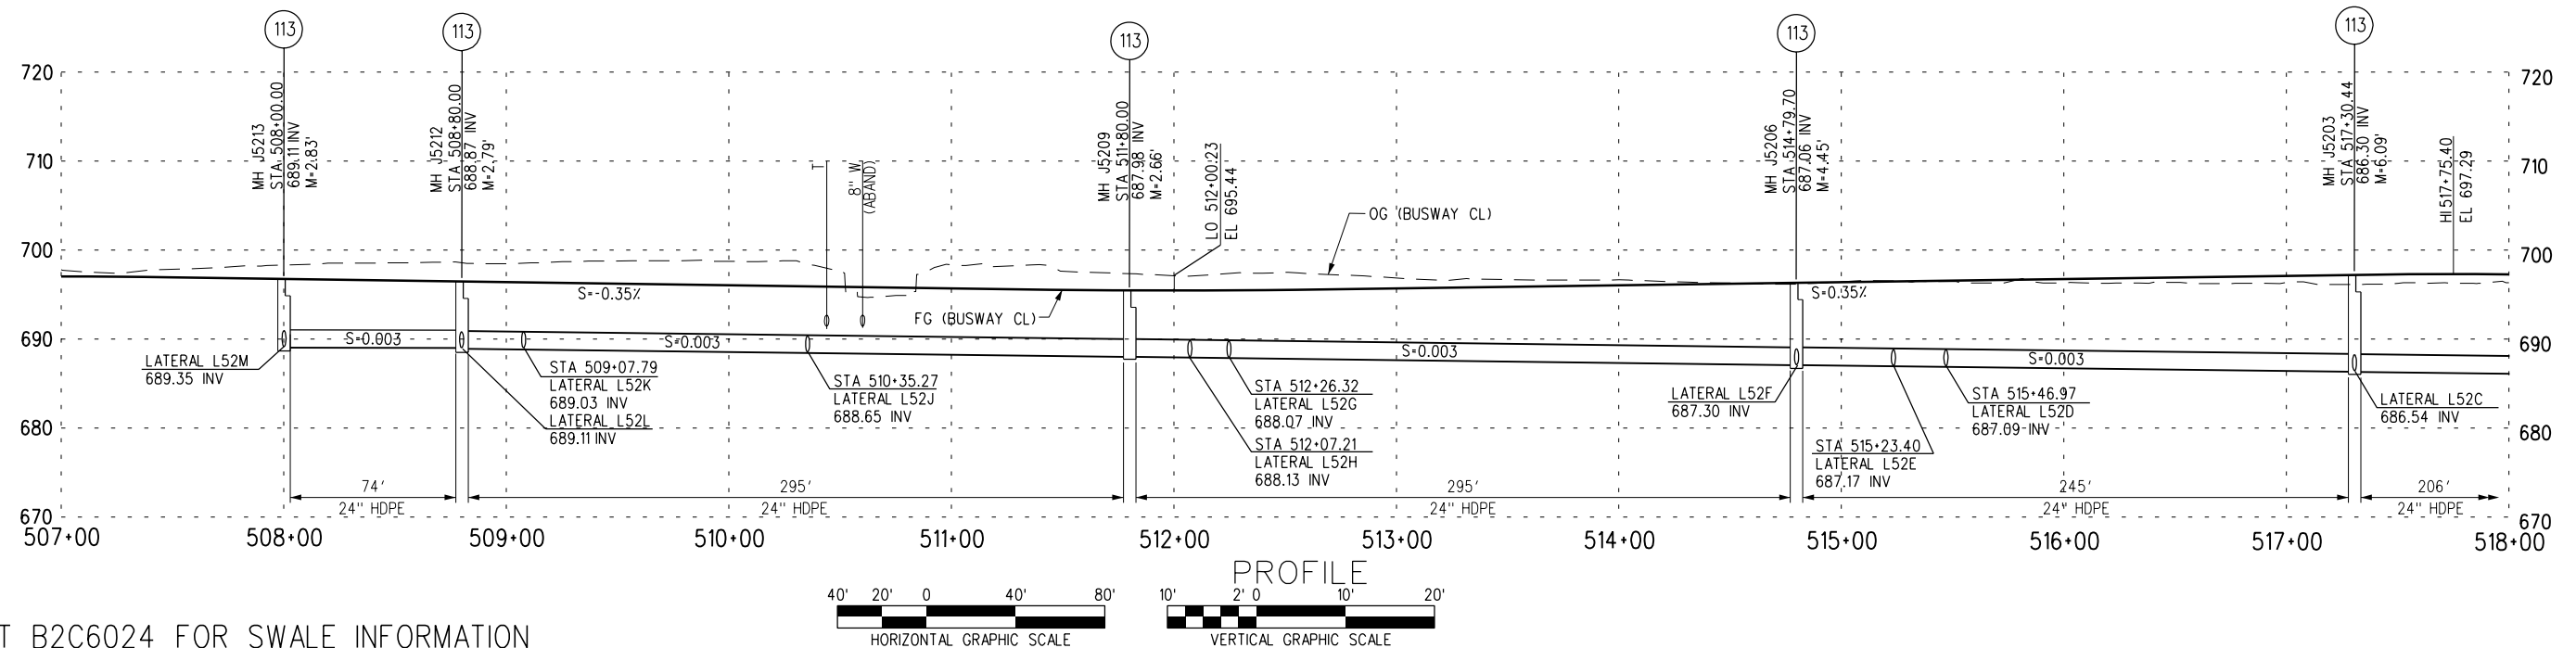

SEE SHEET B2C6024 FOR SWALE INFORMATION

								DESIGNED BY B. MOLINE			LOS ANGELES COUNTY METROPOLITAN TRANSPORTATION AUTHORITY SAN FERNANDO VALLEY EAST-WEST BRT PROJECT	Washington Group International WASHINGTON GROUP INTERNATIONAL, INC. 5805 SEPULVEDA BLVD., SUITE 500 VAN NUYS, CA 91411	SHIMMICK OBAYASHI, JV 5805 SEPULVEDA BLVD., SUITE 500 VAN NUYS, CA 91411	BUSWAY SEGMENT 2 EAST DRAINAGE PLAN & PROFILE STA 507+00 TO STA 518+00 SHEET 7 OF 8	CONTRACT NO C0675		
								DRAWN BY J. MILLER							DRAWING NO B2C6031		REV 1
								CHECKED BY J. HART							SCALE HORIZ. 1"=40' VERT. 1"=10'		SHEET NO
								IN CHARGE J. HART									
1	3/24/04	HB	DO	C56818	06/30/05	DAVID A. ORTIZ	PARK AND RIDE CHANGES	DATE 02/12/04									
0	3/24/04	HB	DO	C56818	06/30/05	DAVID A. ORTIZ	ISSUE FOR CONSTRUCTION										
REV	DATE	BY	APP	REG NO	EXPIRES	SEAL HOLDER	DESCRIPTION										