


THE CITY OF LOS ANGELES OR ITS OFFICERS OR AGENTS SHALL NOT BE RESPONSIBLE FOR THE ACCURACY OR COMPLETENESS OF ELECTRONIC COPIES OF THIS PLAN SHEET.

REVISION DATES
(DESIGN STAGE ONLY)

Sheet Version 2.01

L
K
J
I
H
G
F
E
D
C
B
A

1 2 3 4 5 6 7 8 9 10 11 12 13 14 15 16

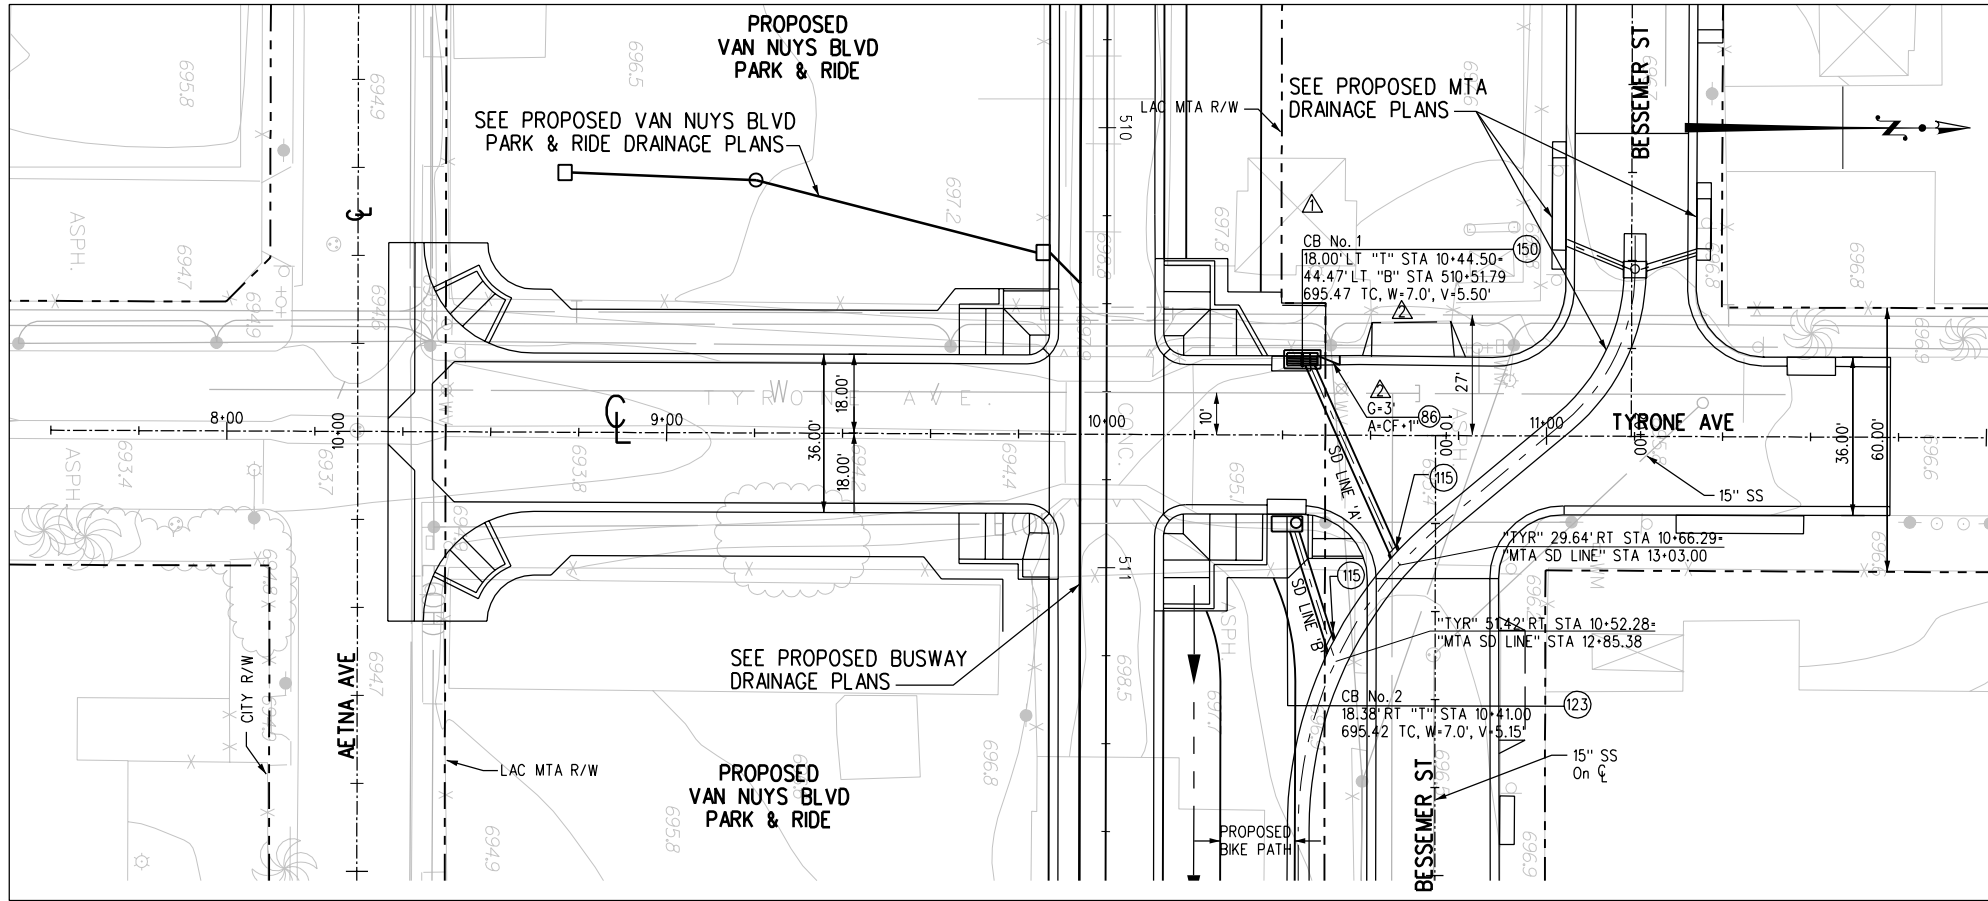

CONSTRUCTION SYMBOLS

- CONSTRUCT
- EXISTING
- REMOVE
- REMODEL EXISTING
- REMOVE AND RECONSTRUCT
- WORK BY OTHERS
- PROTECT IN PLACE

XXX — DENOTES SAWCUT AND JOIN

O.C. — DENOTES "ON CURB"


— DENOTES BUSWAY ROUTE
SEE BUSWAY PLANS

— — — DENOTES EXISTING

— - - DENOTES CENTER LINE

NOTES:

- FOR ACCURATE BUSWAY INFORMATION SEE BUSWAY PLANS.
- FOR EXISTING UTILITIES AND UTILITY RELOCATION SEE UTILITY PLANS.
- FOR CONSTRUCTION NOTES SEE DWG G6B-003.
- CURB FACE FOR TYRONE AVE SHALL BE 8" UNLESS OTHERWISE NOTED.
- FOR ACCURATE CROSSWALK LOCATIONS SEE STRIPING PLANS.
- MTA OWNED AND MAINTAINED CB'S NO.1 & 2 AND TO LINE 'A' & 'B'.
- SEE DRAWING B1C6037 DETAIL 3 FOR CATCH BASIN AND LATERAL LAYOUT.

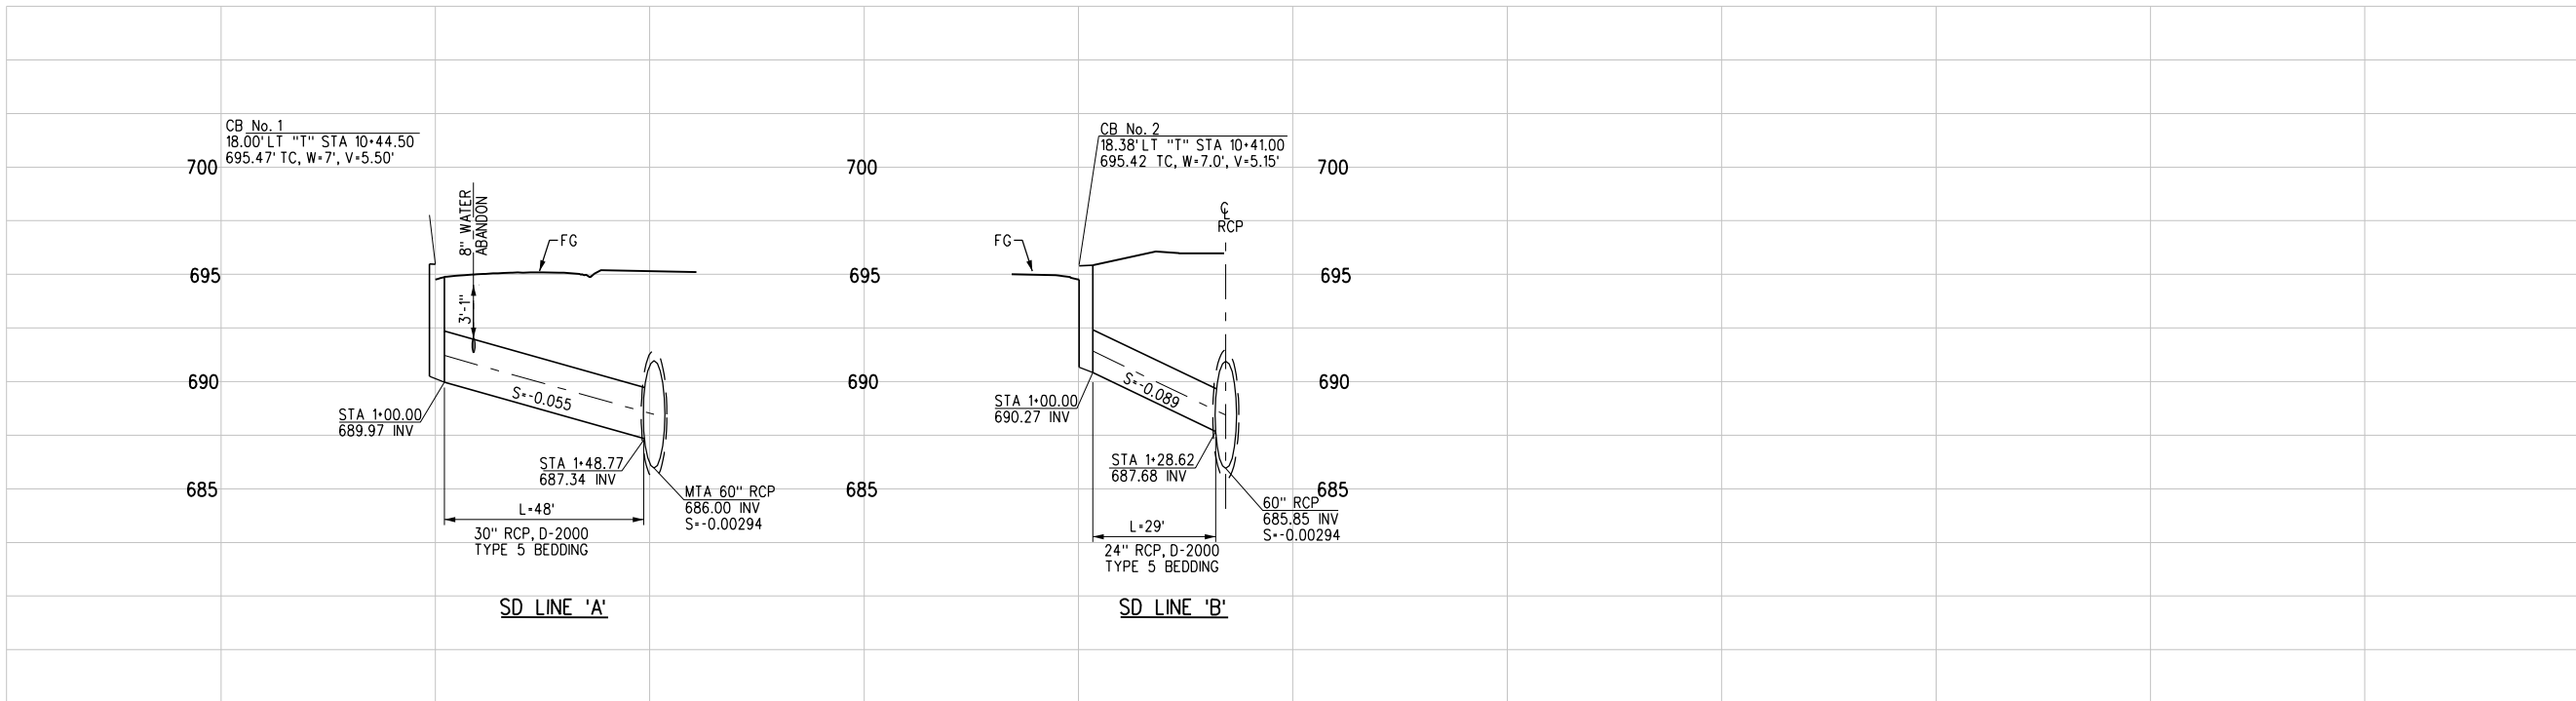

REV	DATE	BY	APP	REG NO	EXPIRES	SEAL HOLDER	DESCRIPTION
1	4/06/05	HAB	AKJ	C42345	03/31/06	ARVIND K. JOSHI	RESPONSE RF1*419 IFC
0	8/31/04	HAB	AKJ	C42345	03/31/06	ARVIND K. JOSHI	ISSUE FOR CONSTRUCTION

DESIGNED BY
H. BULLOCK
DRAWN BY
N. HERNANDEZ
CHECKED BY
J. VALLE
IN CHARGE
A. JOSHI
DATE
6/30/04



LOS ANGELES COUNTY METROPOLITAN TRANSPORTATION AUTHORITY
SAN FERNANDO VALLEY EAST-WEST BRT PROJECT

Washington Group International
WASHINGTON GROUP INTERNATIONAL, INC.
5805 SEPULVEDA BLVD., SUITE 500
VAN NUYS, CA 91411

SHIMMICK
OBAYASHI, JV
5805 SEPULVEDA BLVD., SUITE 500
VAN NUYS, CA 91411

AS-BUILT
STREET IMPROVEMENTS GROUP 6
DRAINAGE PLAN AND PROFILE
TYRONE AVE

DRAWING NO	REV
G6C6-001	1
SCALE	HORIZ. SCALE: 1"=20' VERT. SCALE: 1"=4'
SHEET NO	

BUREAU OF ENGINEERING

DATE: 8/31/04
BY: HAB

ISSUED FOR CONSTRUCTION: 4/6/05
RESPONSE RF1*419 IFC: HAB

AS-BUILT: 11/09/05
AU

SERIAL NO. 1

WORK ACCEPTED: [Signature]

INDEX NO. [Blank]

DEPARTMENT OF PUBLIC WORKS

CITY ENGINEER: GARY LEE MOORE, P.E.

ACCEPTED BY: [Signature]

DATE: [Blank]

DATE: [Blank]

DATE: [Blank]

CITY OF LOS ANGELES

NAV088, 1988 ADJ
HORIZONTAL CONTROL: NAD83, EPOCH 1995.0

SHEET TITLE: PLANS

PROJECT: SAN FERNANDO VALLEY EAST-WEST PROJECT

PLAN CHECKER: [Blank]

DIVISION / DISTRICT ENGINEER: [Blank]

PROJECT NO. [Blank]

DRAWING NO. 1

SHEET OF SHEETS