


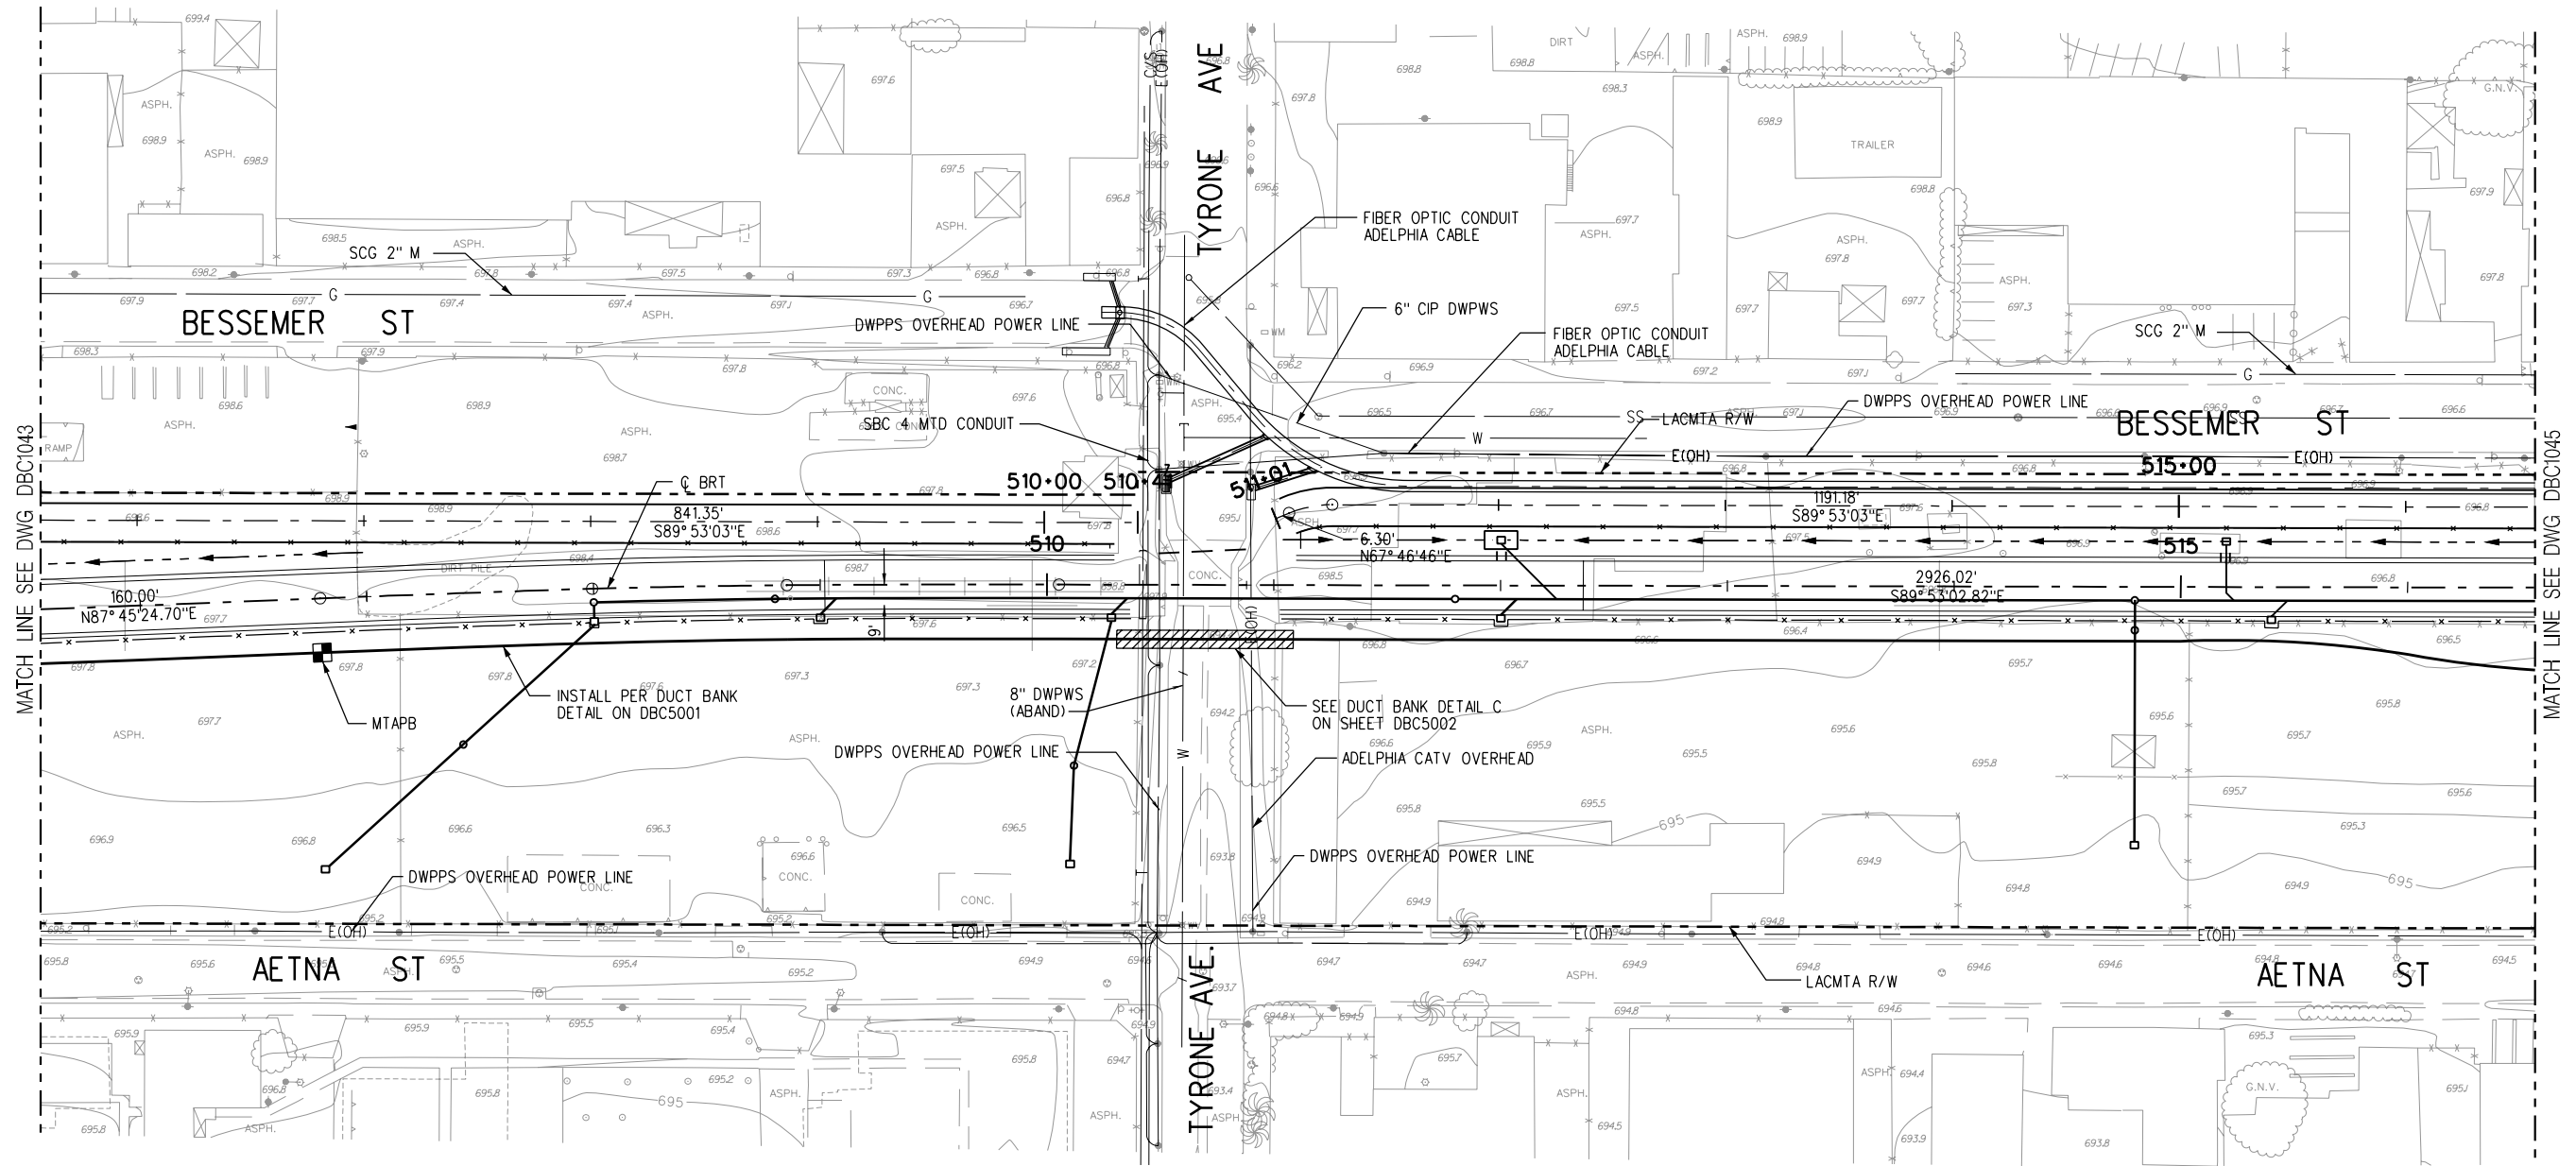

AS-BUILT RECORD DRAWING

REVIEWED AND APPROVED BY: *Garry J. Jess*
GARRY J. JESS, PROJECT MANAGER
WASHINGTON GROUP INTERNATIONAL


CONTRACT NO.		C0675
DRAWING NO.	DBC1044	REV 1
SCALE	HORIZ. 1"=40'	
SHEET NO.		

05/18/2006 09:13:34 AM M:\BRT Irvine\AS-BUILT\ (Merged)\MTA (WGI)\DBC\dbc1044_AS-BUILT.plg

michael.eyre

1	11/23/05	WJ	TG				AS-BUILT RECORD DRAWING
0	3/15/04	BEJ	AKJ	C42345	03/31/06	ARVIND K. JOSHI	IFC SEGMENT 2
REV	DATE	BY	APP	REG NO	EXPIRES	SEAL HOLDER	DESCRIPTION

DESIGNED BY	S. YOUSEFIAN
DRAWN BY	A. GOMEZ
CHECKED BY	P. ANTICH
IN CHARGE	B. JONES
DATE	11/12/03

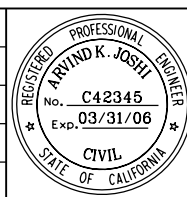

LOS ANGELES COUNTY METROPOLITAN TRANSPORTATION AUTHORITY
SAN FERNANDO VALLEY EAST-WEST BRT PROJECT

WASHINGTON GROUP INTERNATIONAL, INC.
5805 SEPULVEDA BLVD., SUITE 500
VAN NUYS, CA 91411

SHIMMICK
OBAYASHI, JV
5805 SEPULVEDA BLVD., SUITE 500
VAN NUYS, CA 91411

NORTH HOLLYWOOD TO
WARNER CENTER
MAIN LINE DUCT BANK
STA 505+57 TO STA 516+57