


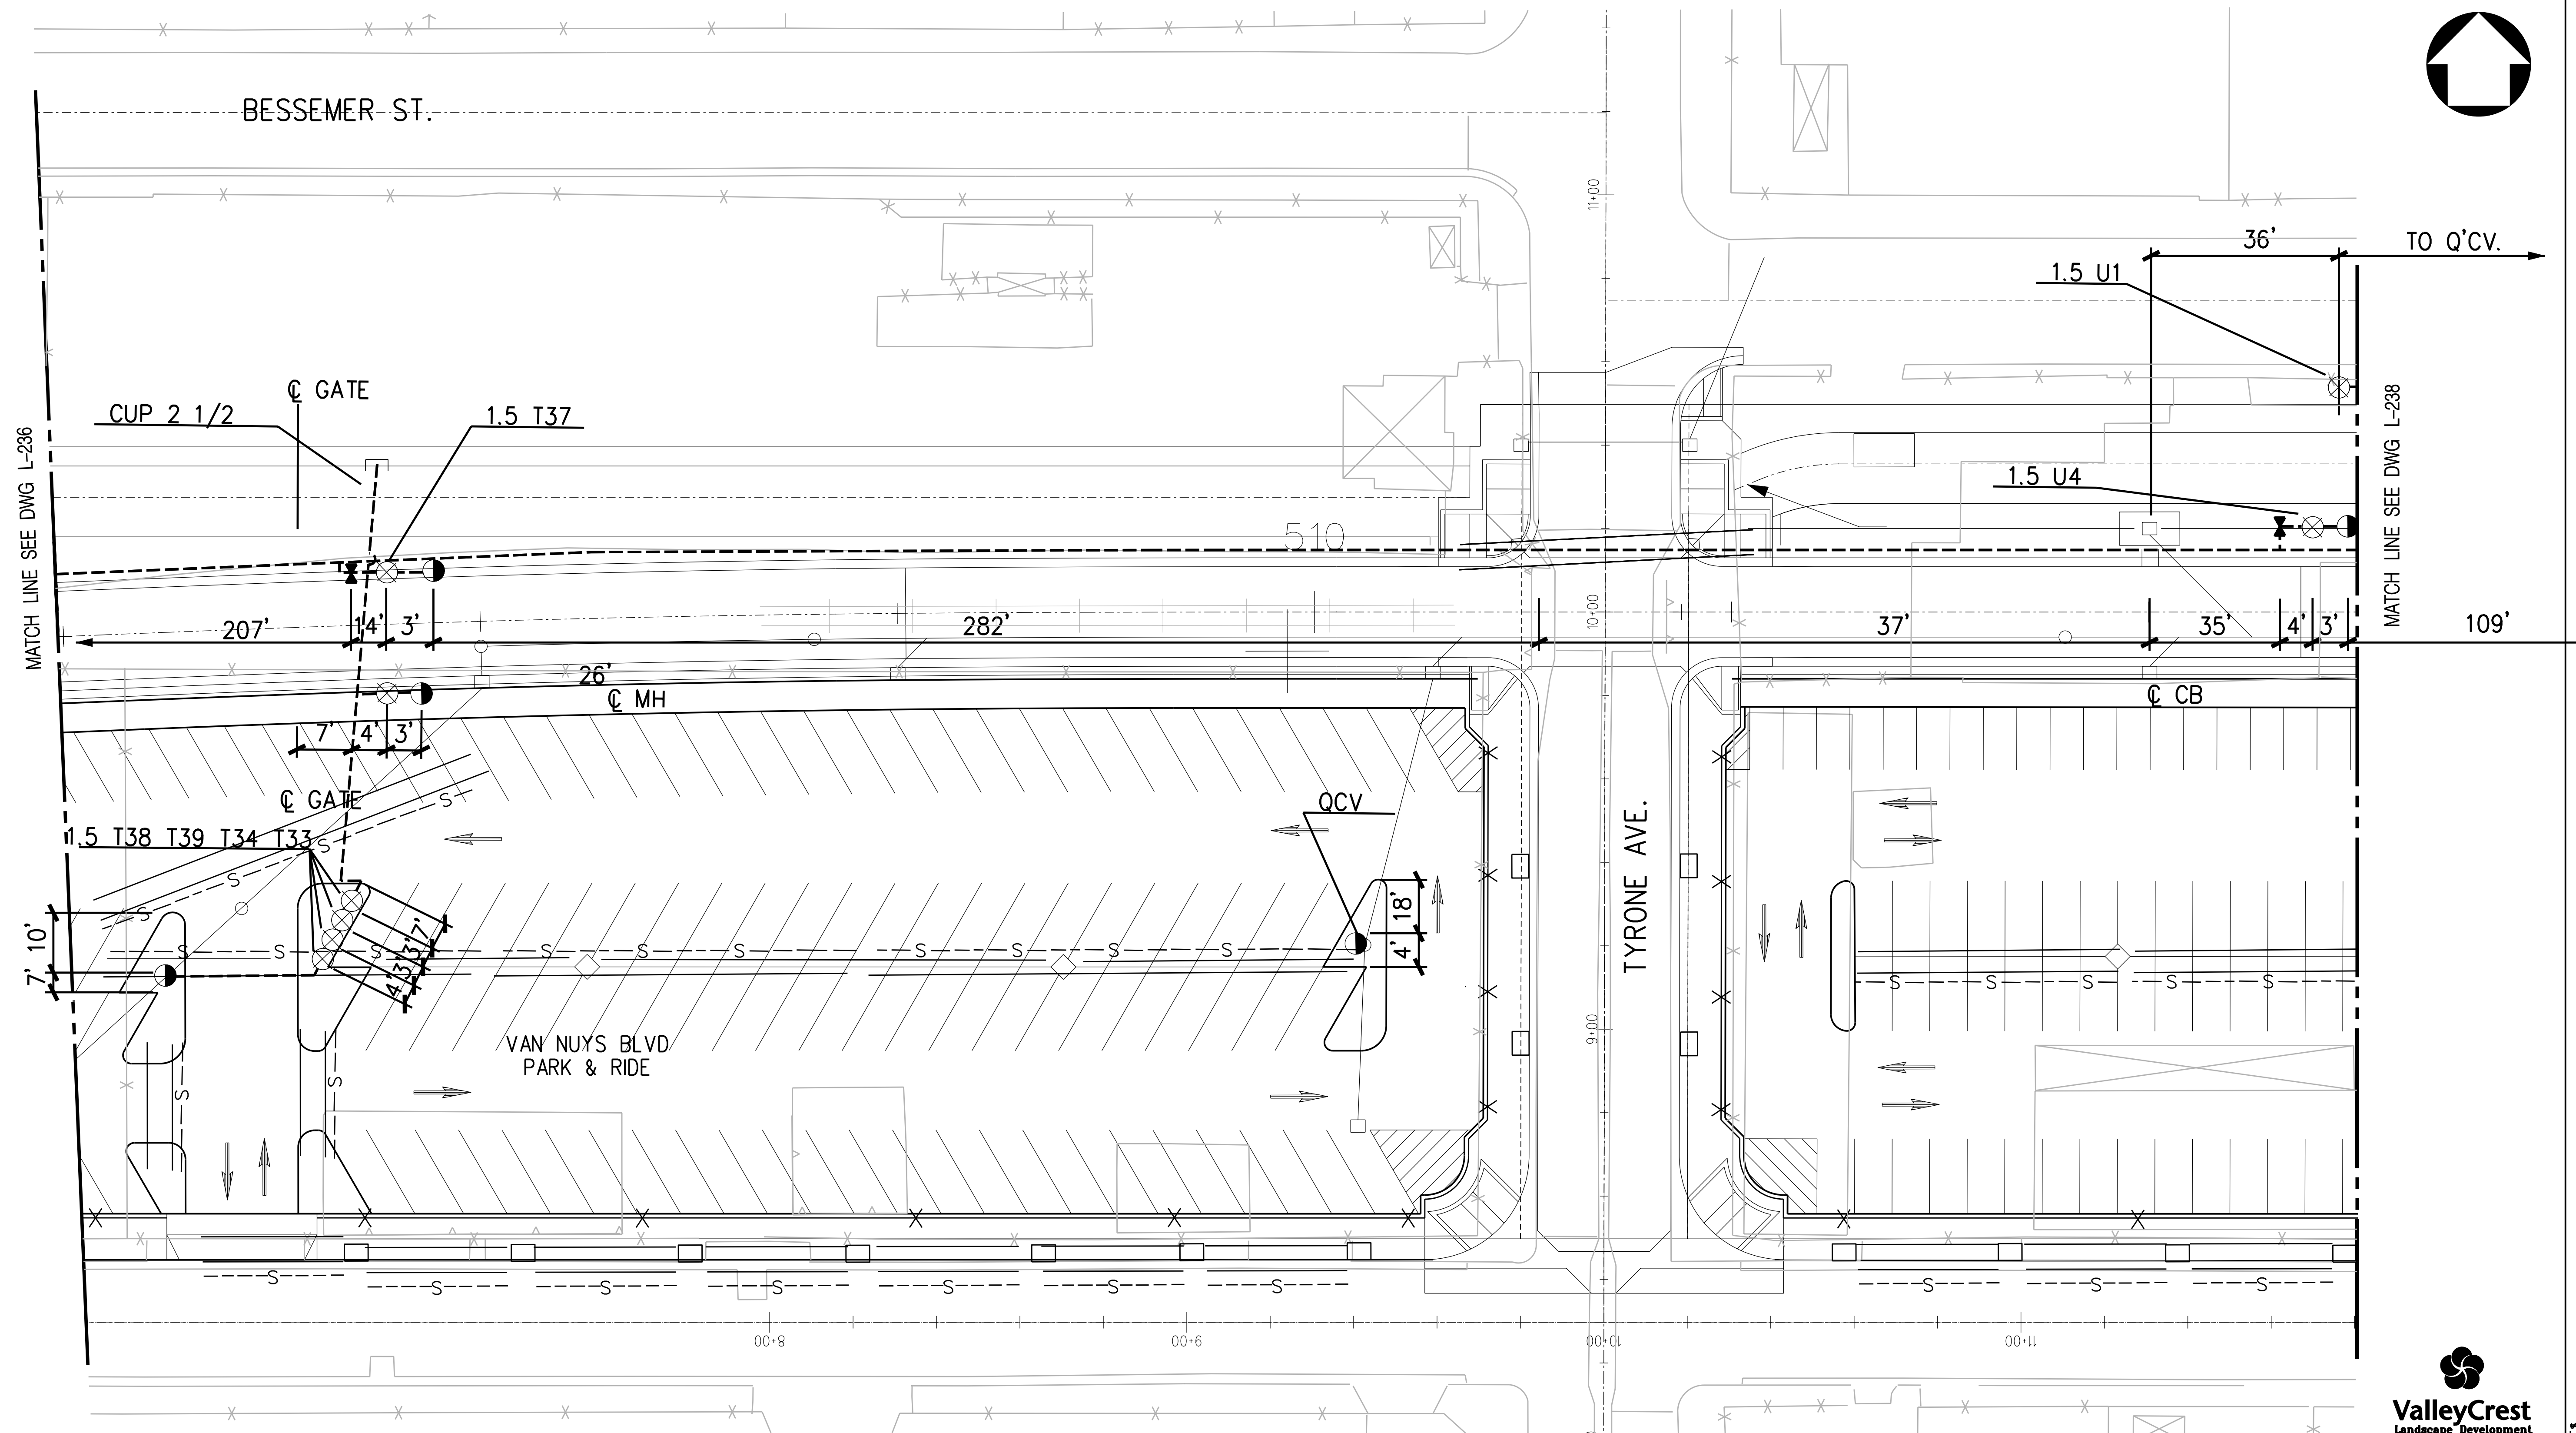


MATCH LINE SEE DWG L-238

ValleyCrest
Landscape Development
AS-BUILT DOCUMENTS

CONTRACT NO		C0675
DRAWING NO	L- 237	REV 0
SCALE 1"=20'		
SHEET NO		

Mike, G

	3/12/08						AS-BUILTS
0	5/23/05						ISSUE FOR CONSTRUCTION
REV	DATE	BY	APP	REG NO	EXPIRES	SEAL HOLDER	DESCRIPTION

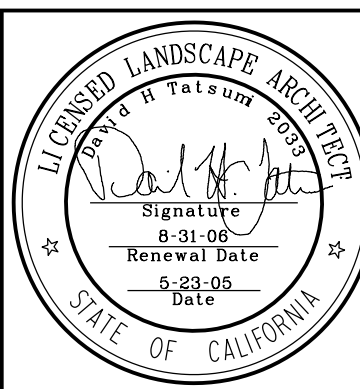

	LOS ANGELES COUNTY METROPOLITAN TRANSPORTATION AUTHORITY SAN FERNANDO VALLEY EAST-WEST BRT PROJECT
	TATSUMI AND PARTNERS, INC. LANDSCAPE ARCHITECTURE • PLANNING • DESIGN 5 CORPORATE PARK, SUITE 200 IRVINE, CA 92618-2860 949/250-9890 FAX 949/250-1891
SUBMITTED BY: _____	DATE: _____
DAVID H. TATSUMI	

NORTH HOLLYWOOD TO
WARNER CENTER
IRRIGATION PLAN
STA 507+00 TO STA 512+50
SHEET 95 OF 136