


TYRONE AVE.



NOTES:
1. MANHOLE INVERT ELEVATIONS
BASED ON NGVD 29
2. UNLESS OTHERWISE NOTED,
ALL UTILITIES ARE LOW RISK
3. UTILITIES ARE BASED ON AVAILABLE
AS-BUILT AND POT HOLE DATA.
UTILITIES SHALL BE FIELD VERIFIED
BY CONTRACTOR PRIOR TO CONSTRUCTION.

- e- (electric)
- w- (water)
- ss- (SEWER)
- g- (gas)
- tc- (telecom)

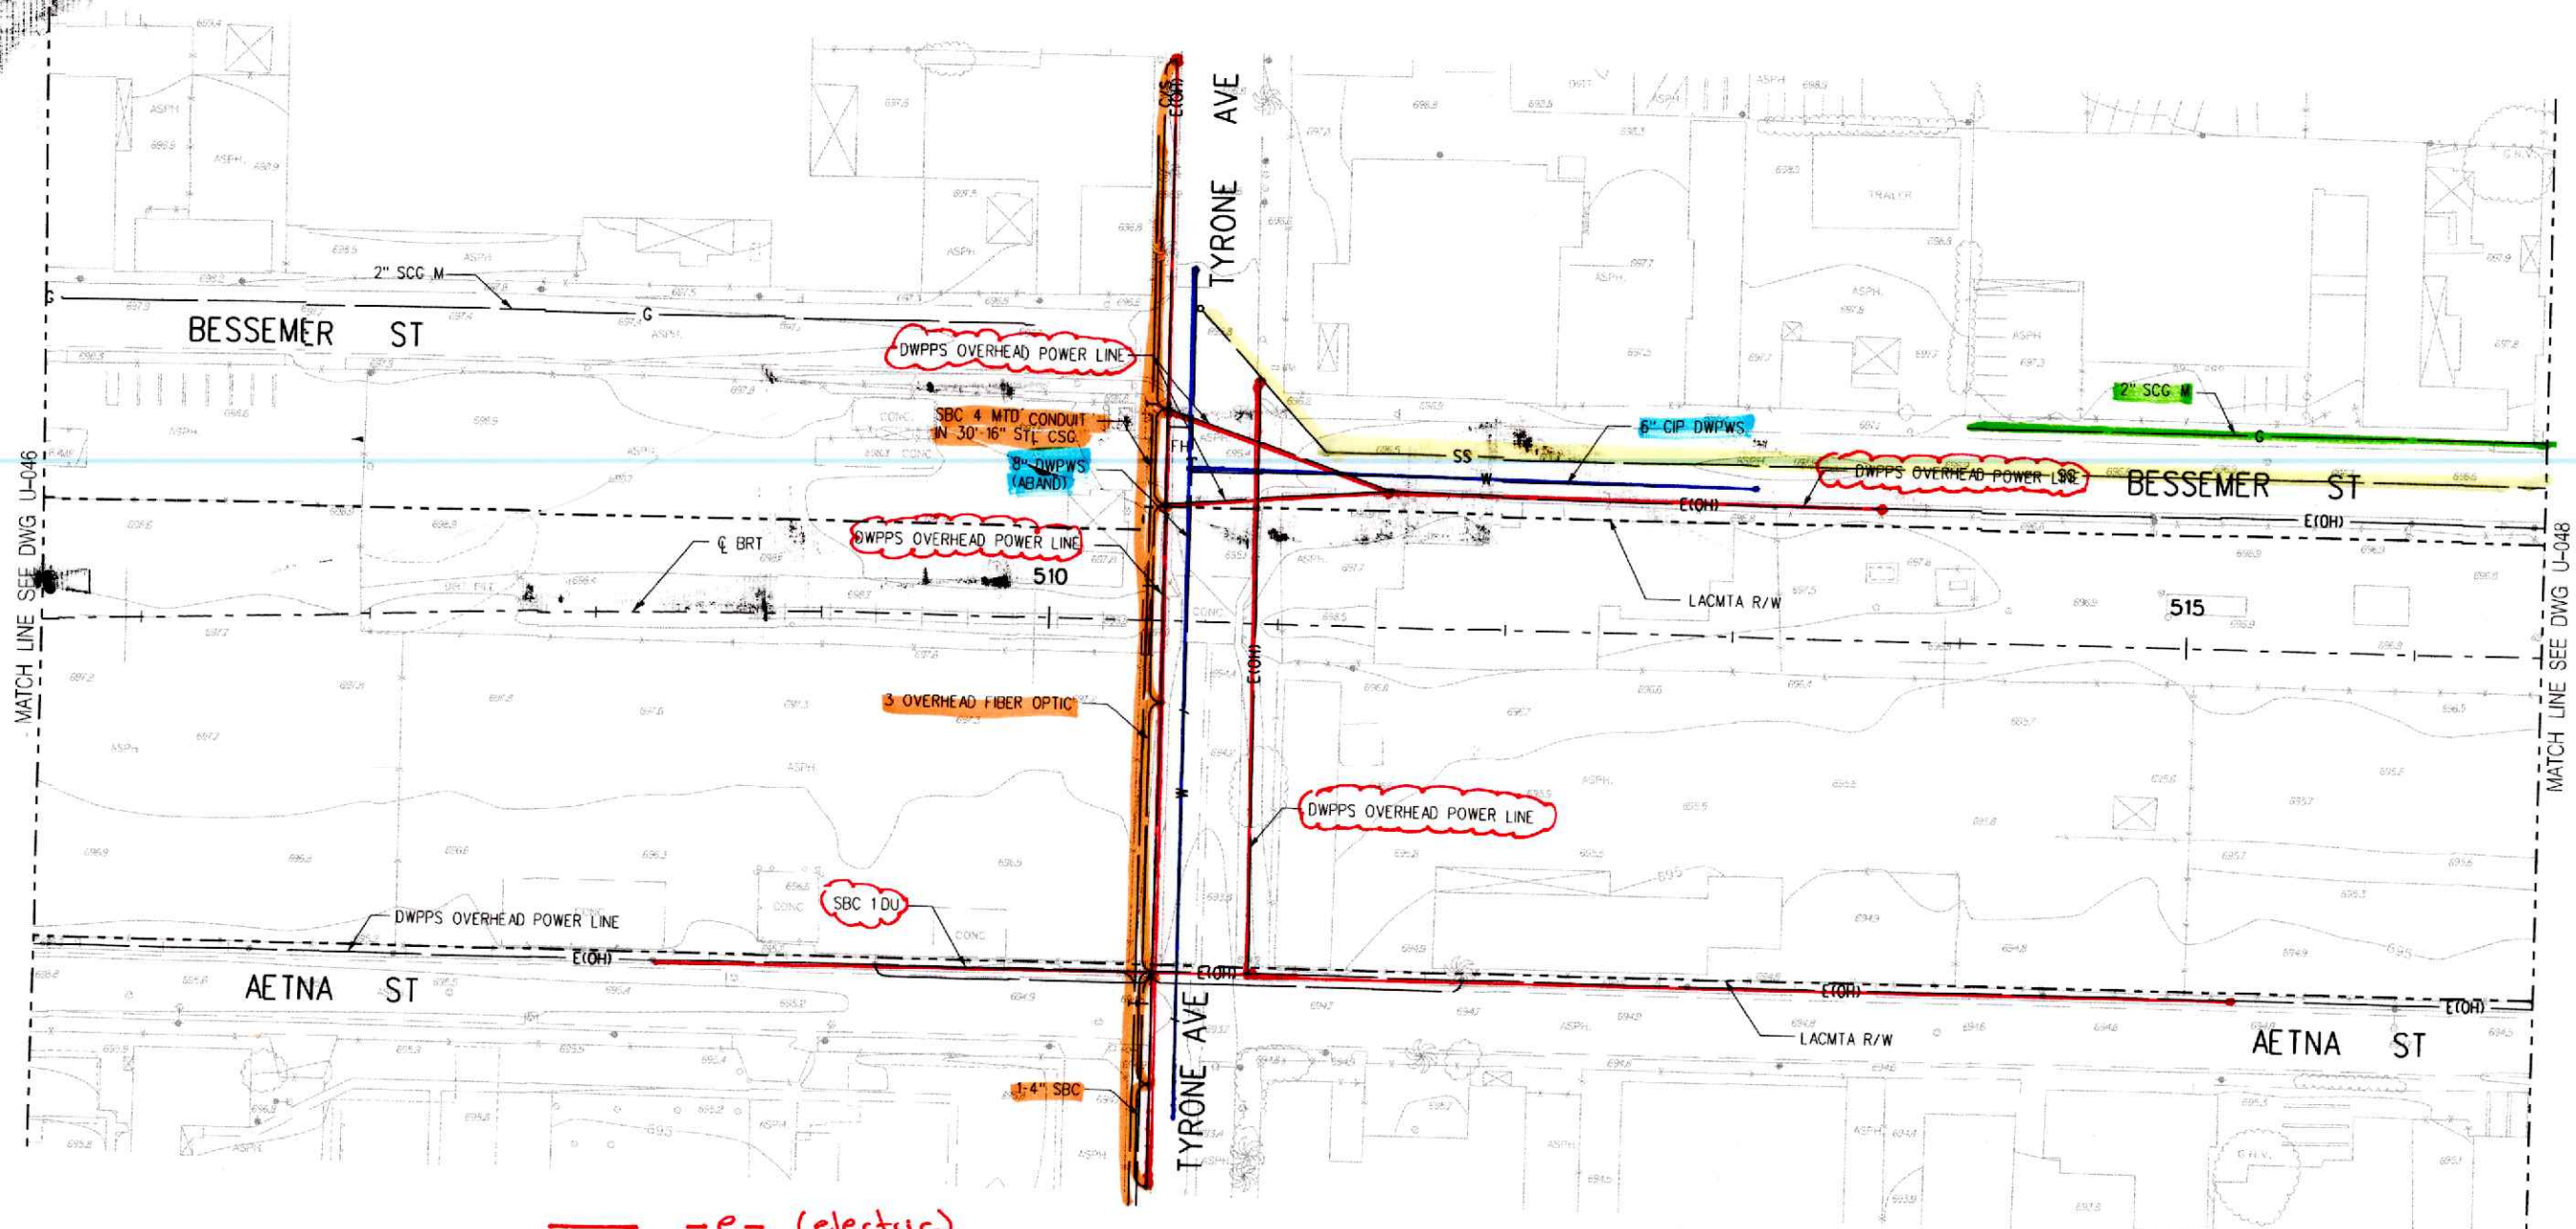

NOT FOR CONSTRUCTION

REV	DATE	BY	APP	REG NO	EXPIRES	SCALE HOLDER	DESCRIPTION
0	4/06/04	AKJ	BEJ	C42345	3/31/06	ARVIND K. JOSHI	ISSUED FOR CONSTRUCTION

DESIGNED BY
S. YOUSEFIAN
DRAWN BY
M. CUTTER
CHECKED BY
D. CONYERS
IN CHARGE
A. JOSHI
DATE
4/06/04



LOS ANGELES COUNTY METROPOLITAN TRANSPORTATION AUTHORITY
SAN FERNANDO VALLEY EAST-WEST BRT PROJECT



Washington Group International
WASHINGTON GROUP INTERNATIONAL, INC.
5805 SEPULVEDA BLVD., SUITE 500
VAN NUYS, CA 91411

SHIMMICK
OBAYASHI, JV
5805 SEPULVEDA BLVD., SUITE 500
VAN NUYS, CA 91411

NORTH HOLLYWOOD TO
WARNER CENTER
UTILITIES
SHEET 05 OF 05

CONTRACT NO	C0675
DRAWING NO	U-047
SCALE	HORIZ. 1"=40'
SHEET NO	0

m:\bvt\irvine\sheet\temp utilities\U-047.plg 11/2006 08:44:45 AM