

6	AS-BUILT	11/17/05	AJ
5	INCORPORATE CITY COMMENTS	7/27/04	WCB
4	100% SUBMITTAL SEGMENT 3	4/17/04	AJ1

BUREAU OF ENGINEERING

BY: YX
 DATE: 11/17/03

NO.	REVISIONS:	DATE:	BY:
0	ISSUED FOR CONSTRUCTION	11/17/03	YX
1	100% SUBMITTAL SEGMENT 1B	12/1/03	BEJ
2	ISSUED FOR CONSTRUCTION - 1B	1/22/04	BEJ
3	100% SUBMITTAL SEGMENT 2	3/10/04	AJ1

WORK ACCEPTED

SERIAL NO.

INDEX NO.

B-PERMITS
 BD/BC




GARY LEE MOORE, P.E.		CITY ENGINEER
ACCEPTED BY:		
	PLAN CHECKER	DATE
	DIVISION / DISTRICT ENGINEER	DATE

VERTICAL CONTROL:	NAVD83, 1985 ADJ
HORIZONTAL CONTROL:	NAD83, EPOCH 1995.0
SHEET TITLE: PLANS	
PROJECT:	SAN FERNANDO VALLEY EAST-WEST PROJECT
ADDRESS:	

PROJECT NO.
BRT

DRAWING NO.
DBC5001

SHEET **1** OF **3** SHEETS

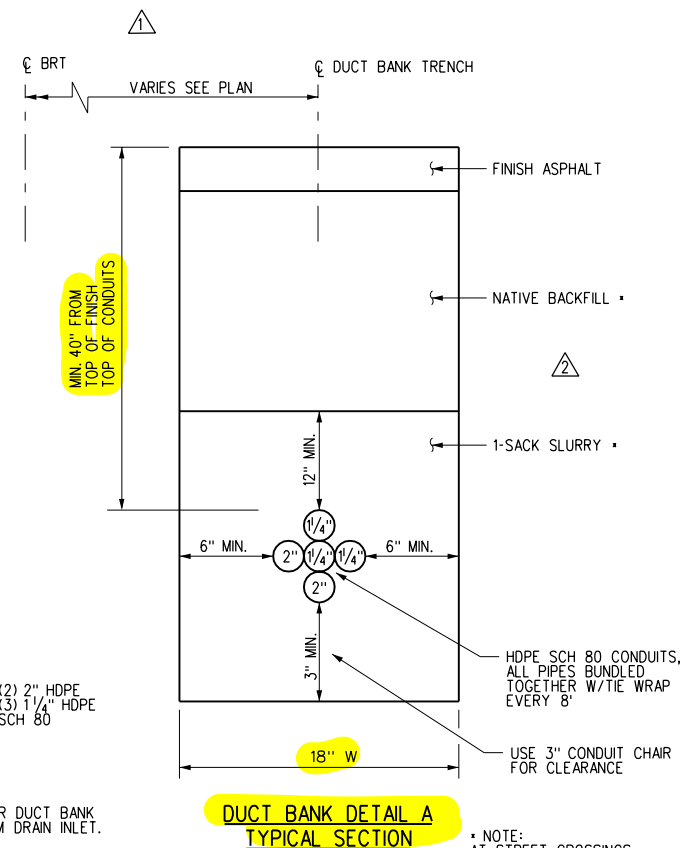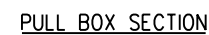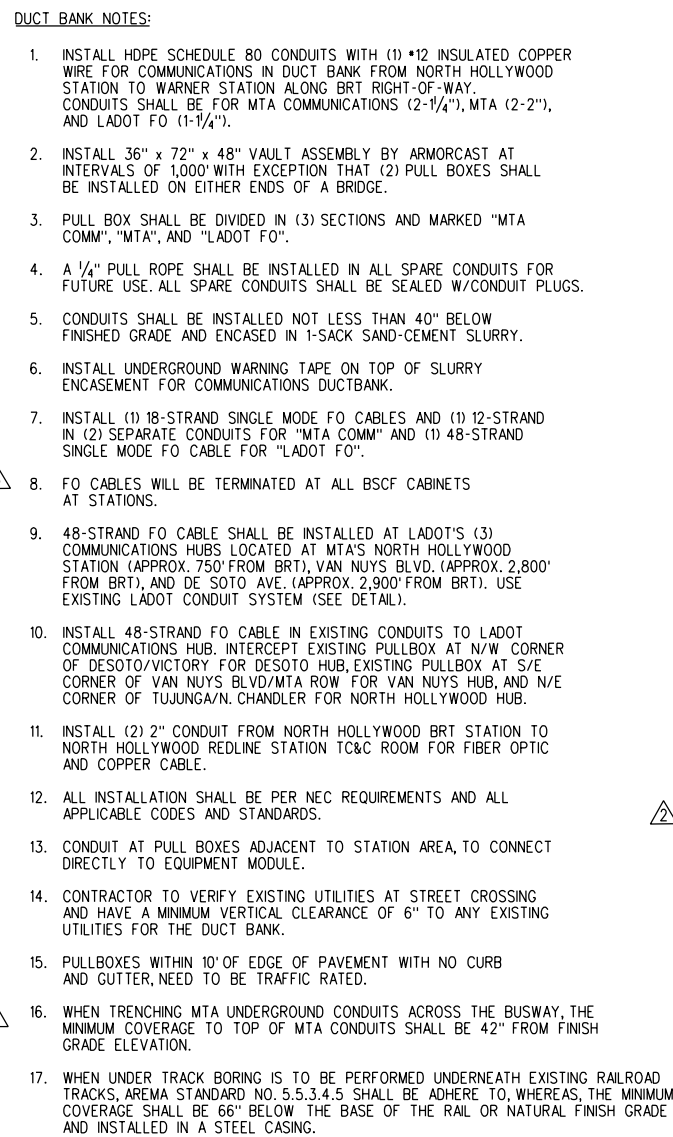

DUCT BANK DETAIL A
TYPICAL SECTION


▪ NOTE:
AT STREET CROSSINGS
USE 1-SACK SLURRY
TO FINISH PAVEMENT

PULL BOX DETAIL

PULL BOX INSTALLED ON 12" THICK BED OF 1" CRUSHED ROCK
EXTENDING 6" BEYOND OUTSIDE EDGES OF PULL BOX.

	5	7/20/04	WCB	AKJ	C42345	03/31/06	ARVIND K. JOSHI	INCORPORATE CITY COMMENTS
	4	4/17/04	AKJ	BEJ	C42345	03/31/06	ARVIND K. JOSHI	100% SUBMITTAL SEGMENT 3
	3	3/10/04	AKJ	BEJ	C59517	12/31/03	BRETT E. JONES	100% SUBMITTAL SEGMENT 2
	2	1/22/04	BEJ	CC	C59517	12/31/03	BRETT E. JONES	ISSUED FOR CONSTRUCTION - 1B
	1	12/1/03	BEJ	CC	C59517	12/31/03	BRETT E. JONES	100% SUBMITTAL SEGMENT 1B
	0	11/7/03	YX	BEJ	C59517	12/31/03	BRETT E. JONES	ISSUED FOR CONSTRUCTION
	REV	DATE	BY	APP	REG NO	EXPIRES	SEAL HOLDER	DESCRIPTION

DESIGNED BY	S. YOUSEFIAN
DRAWN BY	A. GOMEZ
CHECKED BY	P. ANTICH
IN CHARGE	B. JONES
DATE	11/12/03

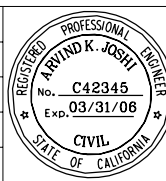

LOS ANGELES COUNTY METROPOLITAN TRANSPORTATION AUTHORITY
SAN FERNANDO VALLEY EAST-WEST BRT PROJECT



Washington Group International
WASHINGTON GROUP INTERNATIONAL, INC.
5805 SEPULVEDA BLVD., SUITE 500
VAN NUYS, CA 91411



SHIMMICK
OBAYASHI, JV
5805 SEPULVEDA BLVD., SUITE 500
VAN NUYS, CA 91411

AS-BUILT

REVIEWED AND
APPROVED BY


GARRY J. JESS - PROJECT MANAGER
WASHINGTON GROUP INTERNATIONAL

NORTH HOLLYWOOD
TO WARNER CENTER
MAIN LINE DUCT BANK DETAILS
SHEET 1 OF 3

CONTRACT NO	C0675
DRAWING NO	DBC5001
SCALE	NO SCALE
SHEET NO	1

THE CITY OF LOS ANGELES OR ITS OFFICERS OR AGENTS SHALL NOT BE RESPONSIBLE FOR THE ACCURACY OR COMPLETENESS OF THIS PLAN SHEET.

REVISION DATES (DESIGN STAGE ONLY)

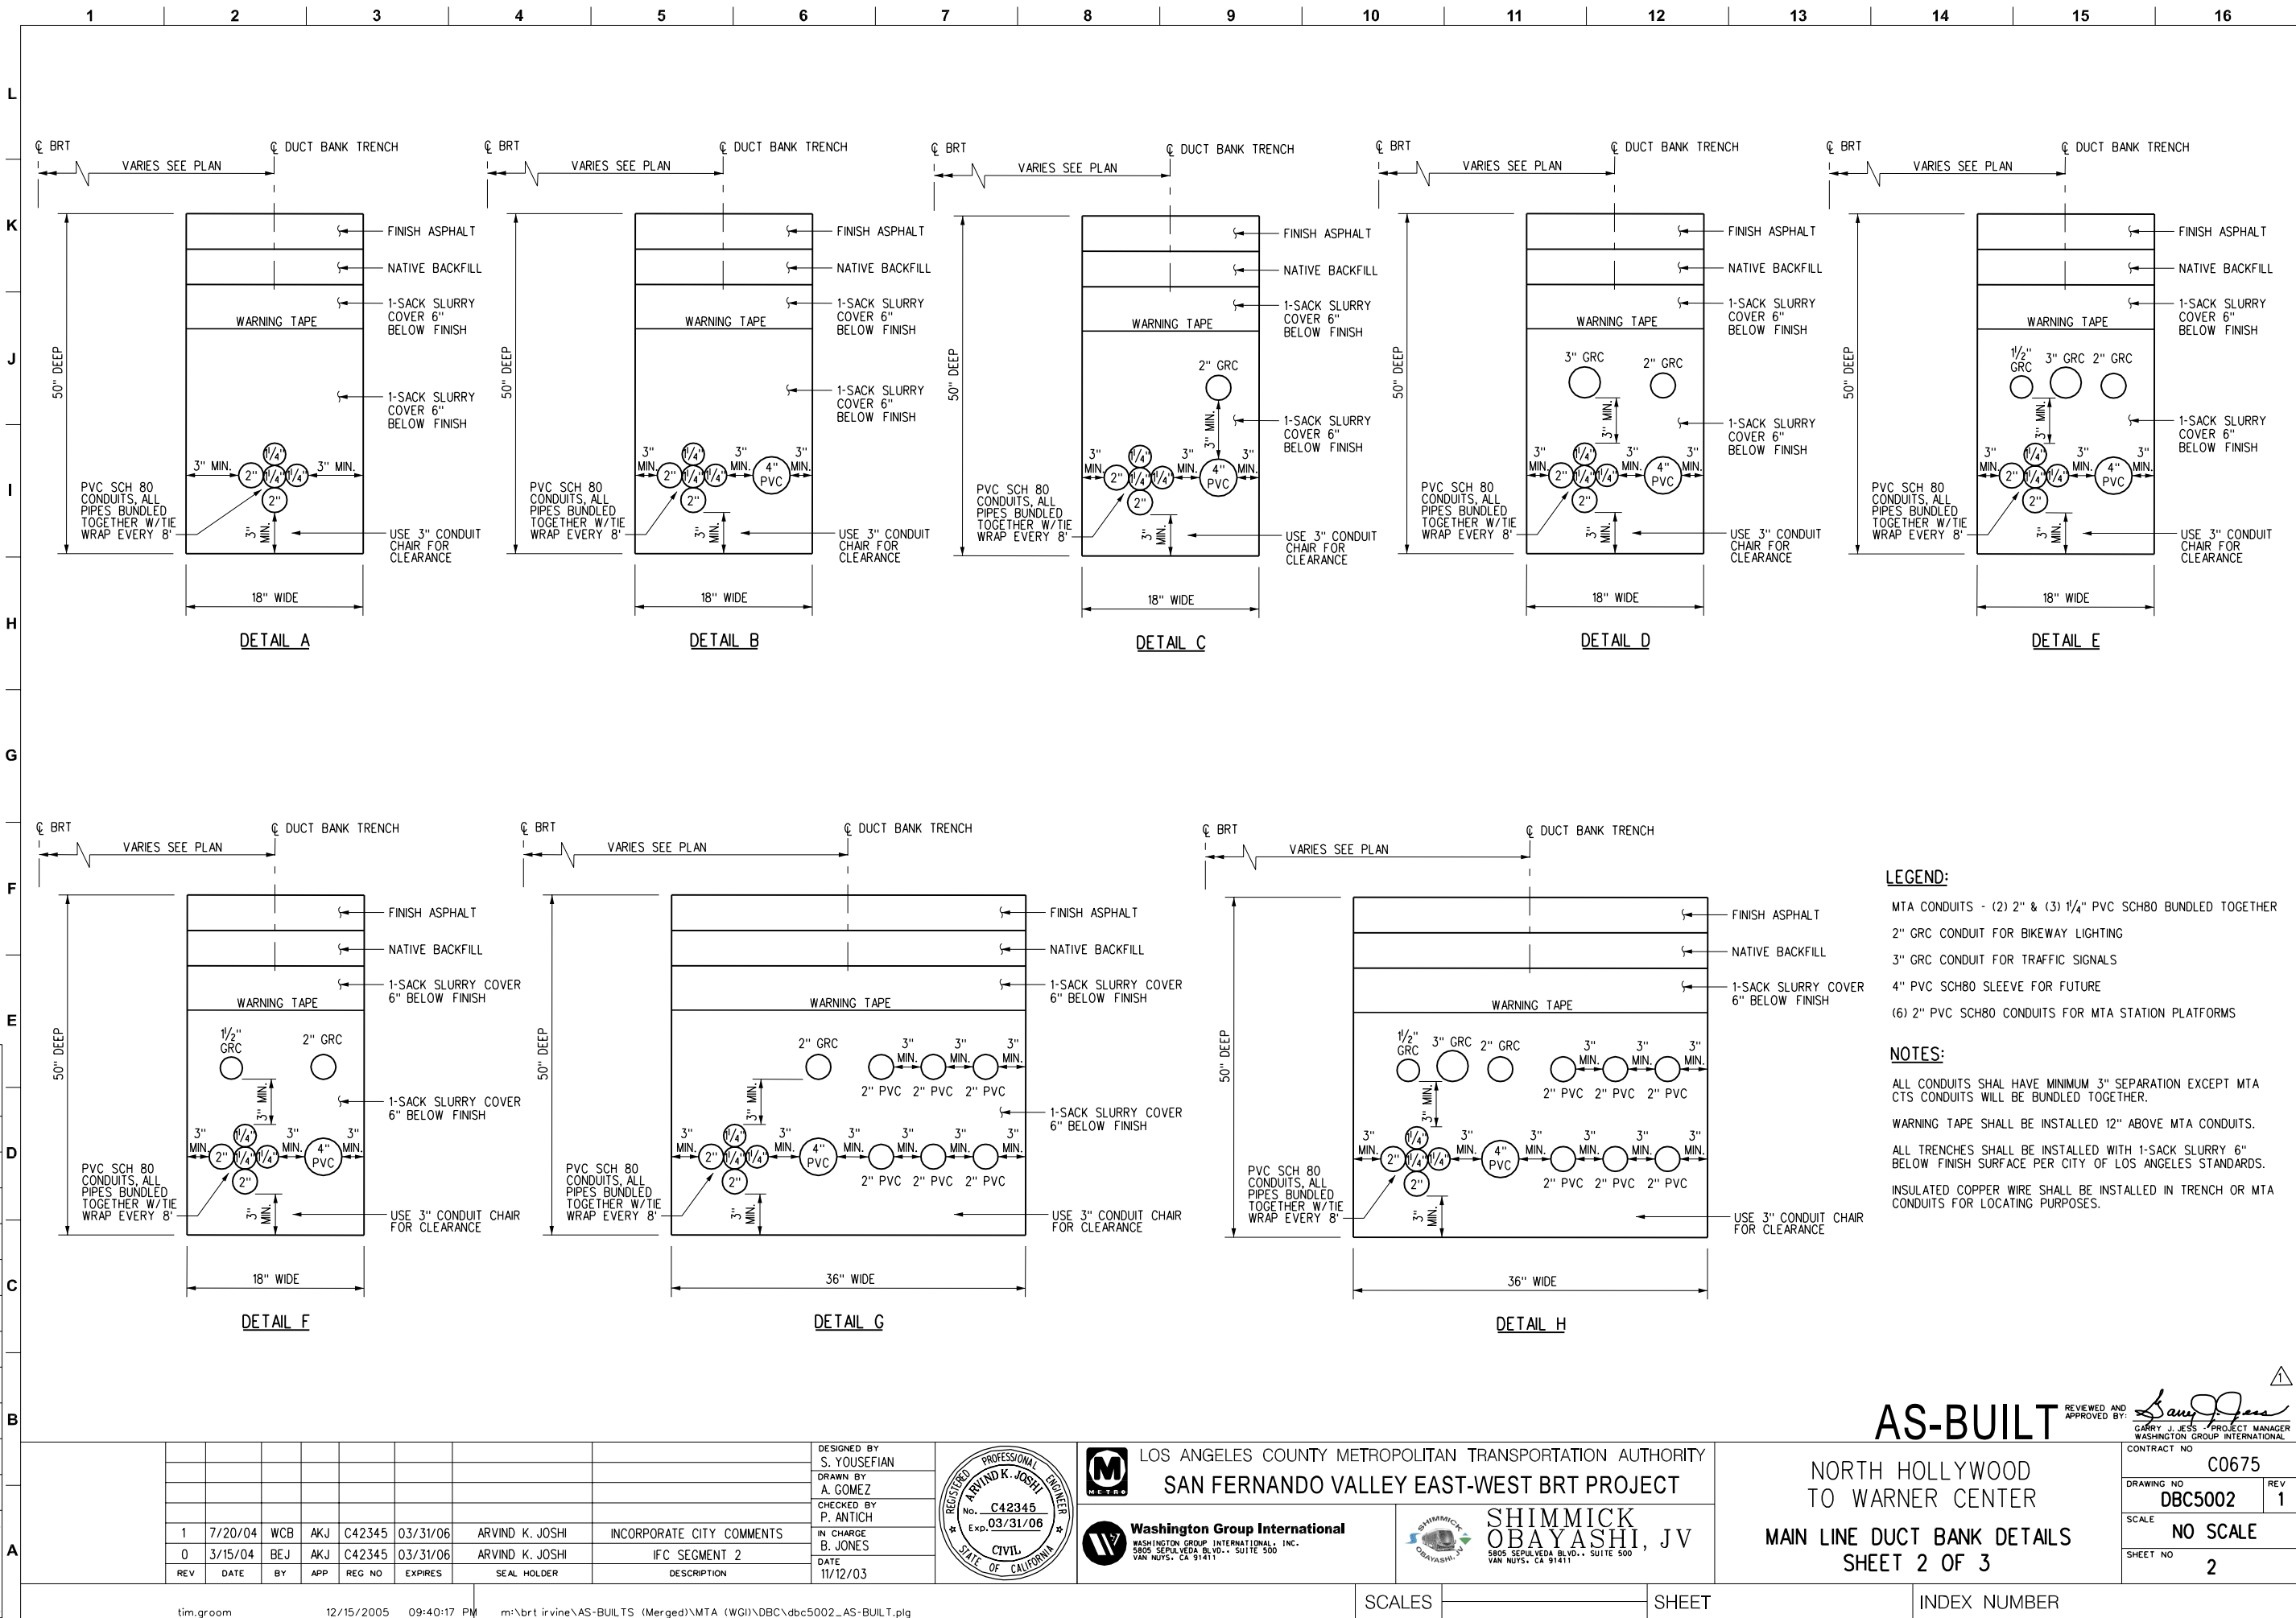

LEGEND:

- MTA CONDUITS - (2) 2" & (3) 1/4" PVC SCH80 BUNDLED TOGETHER
- 2" GRC CONDUIT FOR BIKEWAY LIGHTING
- 3" GRC CONDUIT FOR TRAFFIC SIGNALS
- 4" PVC SCH80 SLEEVE FOR FUTURE
- (6) 2" PVC SCH80 CONDUITS FOR MTA STATION PLATFORMS

NOTES:

- ALL CONDUITS SHAL HAVE MINIMUM 3" SEPARATION EXCEPT MTA CTS CONDUITS WILL BE BUNDLED TOGETHER.
- WARNING TAPE SHALL BE INSTALLED 12" ABOVE MTA CONDUITS.
- ALL TRENCHES SHALL BE INSTALLED WITH 1-SACK SLURRY 6" BELOW FINISH SURFACE PER CITY OF LOS ANGELES STANDARDS.
- INSULATED COPPER WIRE SHALL BE INSTALLED IN TRENCH OR MTA CONDUITS FOR LOCATING PURPOSES.

AS-BUILT

REVIEWED AND APPROVED BY:

GARY J. LEE, PROJECT MANAGER
WASHINGTON GROUP INTERNATIONAL

CONTRACT NO
C0675

DRAWING NO
DBC5002

SCALE
NO SCALE

SHEET NO
2

REV
1

DESIGNED BY
S. YOUSEFIAN

DRAWN BY
A. GOMEZ

CHECKED BY
P. ANTICH

IN CHARGE
B. JONES

DATE
11/12/03

REGISTERED PROFESSIONAL ENGINEER
ARVIND K. JOSHI
No. C42345
Exp. 03/31/08
CIVIL
STATE OF CALIFORNIA

LOS ANGELES COUNTY METROPOLITAN TRANSPORTATION AUTHORITY
SAN FERNANDO VALLEY EAST-WEST BRT PROJECT

WASHINGTON GROUP INTERNATIONAL, INC.
5805 SEPULVEDA BLVD., SUITE 500
VAN NUYS, CA 91411

SHIMMICK
OBAYASHI, JV
5805 SEPULVEDA BLVD., SUITE 500
VAN NUYS, CA 91411

tim.groom 12/15/2005 09:40:17 PM m:\birt irvine\AS-BUILTS (Merged)\MTA (WGI)\DBC\dbc5002_AS-BUILT.plg

BUREAU OF ENGINEERING

LA DPW
ENGINEERING
Sustainable Progress
Lasting Positive Future

DATE: 03/15/04
BY: BEJ

DATE: 07/20/04
BY: WCB

DATE: 11/28/05
BY: AU

REVISIONS:

NO. 0
DATE: 03/15/04
BY: BEJ

NO. 1
DATE: 07/20/04
BY: WCB

NO. 2
DATE: 11/28/05
BY: AU

APPROVALS:

DATE: 03/15/04
BY: BEJ

DATE: 07/20/04
BY: WCB

DATE: 11/28/05
BY: AU

INDEX NO.

B - PERMITS

BD/BC

DEPARTMENT OF PUBLIC WORKS

CITY ENGINEER
GARY LEE MOORE, P.E.

ACCEPTED BY:

DATE

DATE

CITY OF LOS ANGELES

NAV088, 1888 ADJ
HORIZONTAL CONTROL: NAD83, EPOCH 1995.0

PROJECT: SAN FERNANDO VALLEY EAST-WEST PROJECT

ADDRESS:

PLANS

SAN FERNANDO VALLEY EAST-WEST PROJECT


PROJECT NO.
BRT

DRAWING NO.
DBC5002

SHEET 2 OF 3 SHEETS

THE CITY OF LOS ANGELES OR ITS OFFICERS OR AGENTS SHALL NOT BE RESPONSIBLE FOR THE ACCURACY OR COMPLETENESS OF ELECTRONIC COPIES OF THIS PLAN SHEET.

REVISION DATES (DESIGN STAGE ONLY)

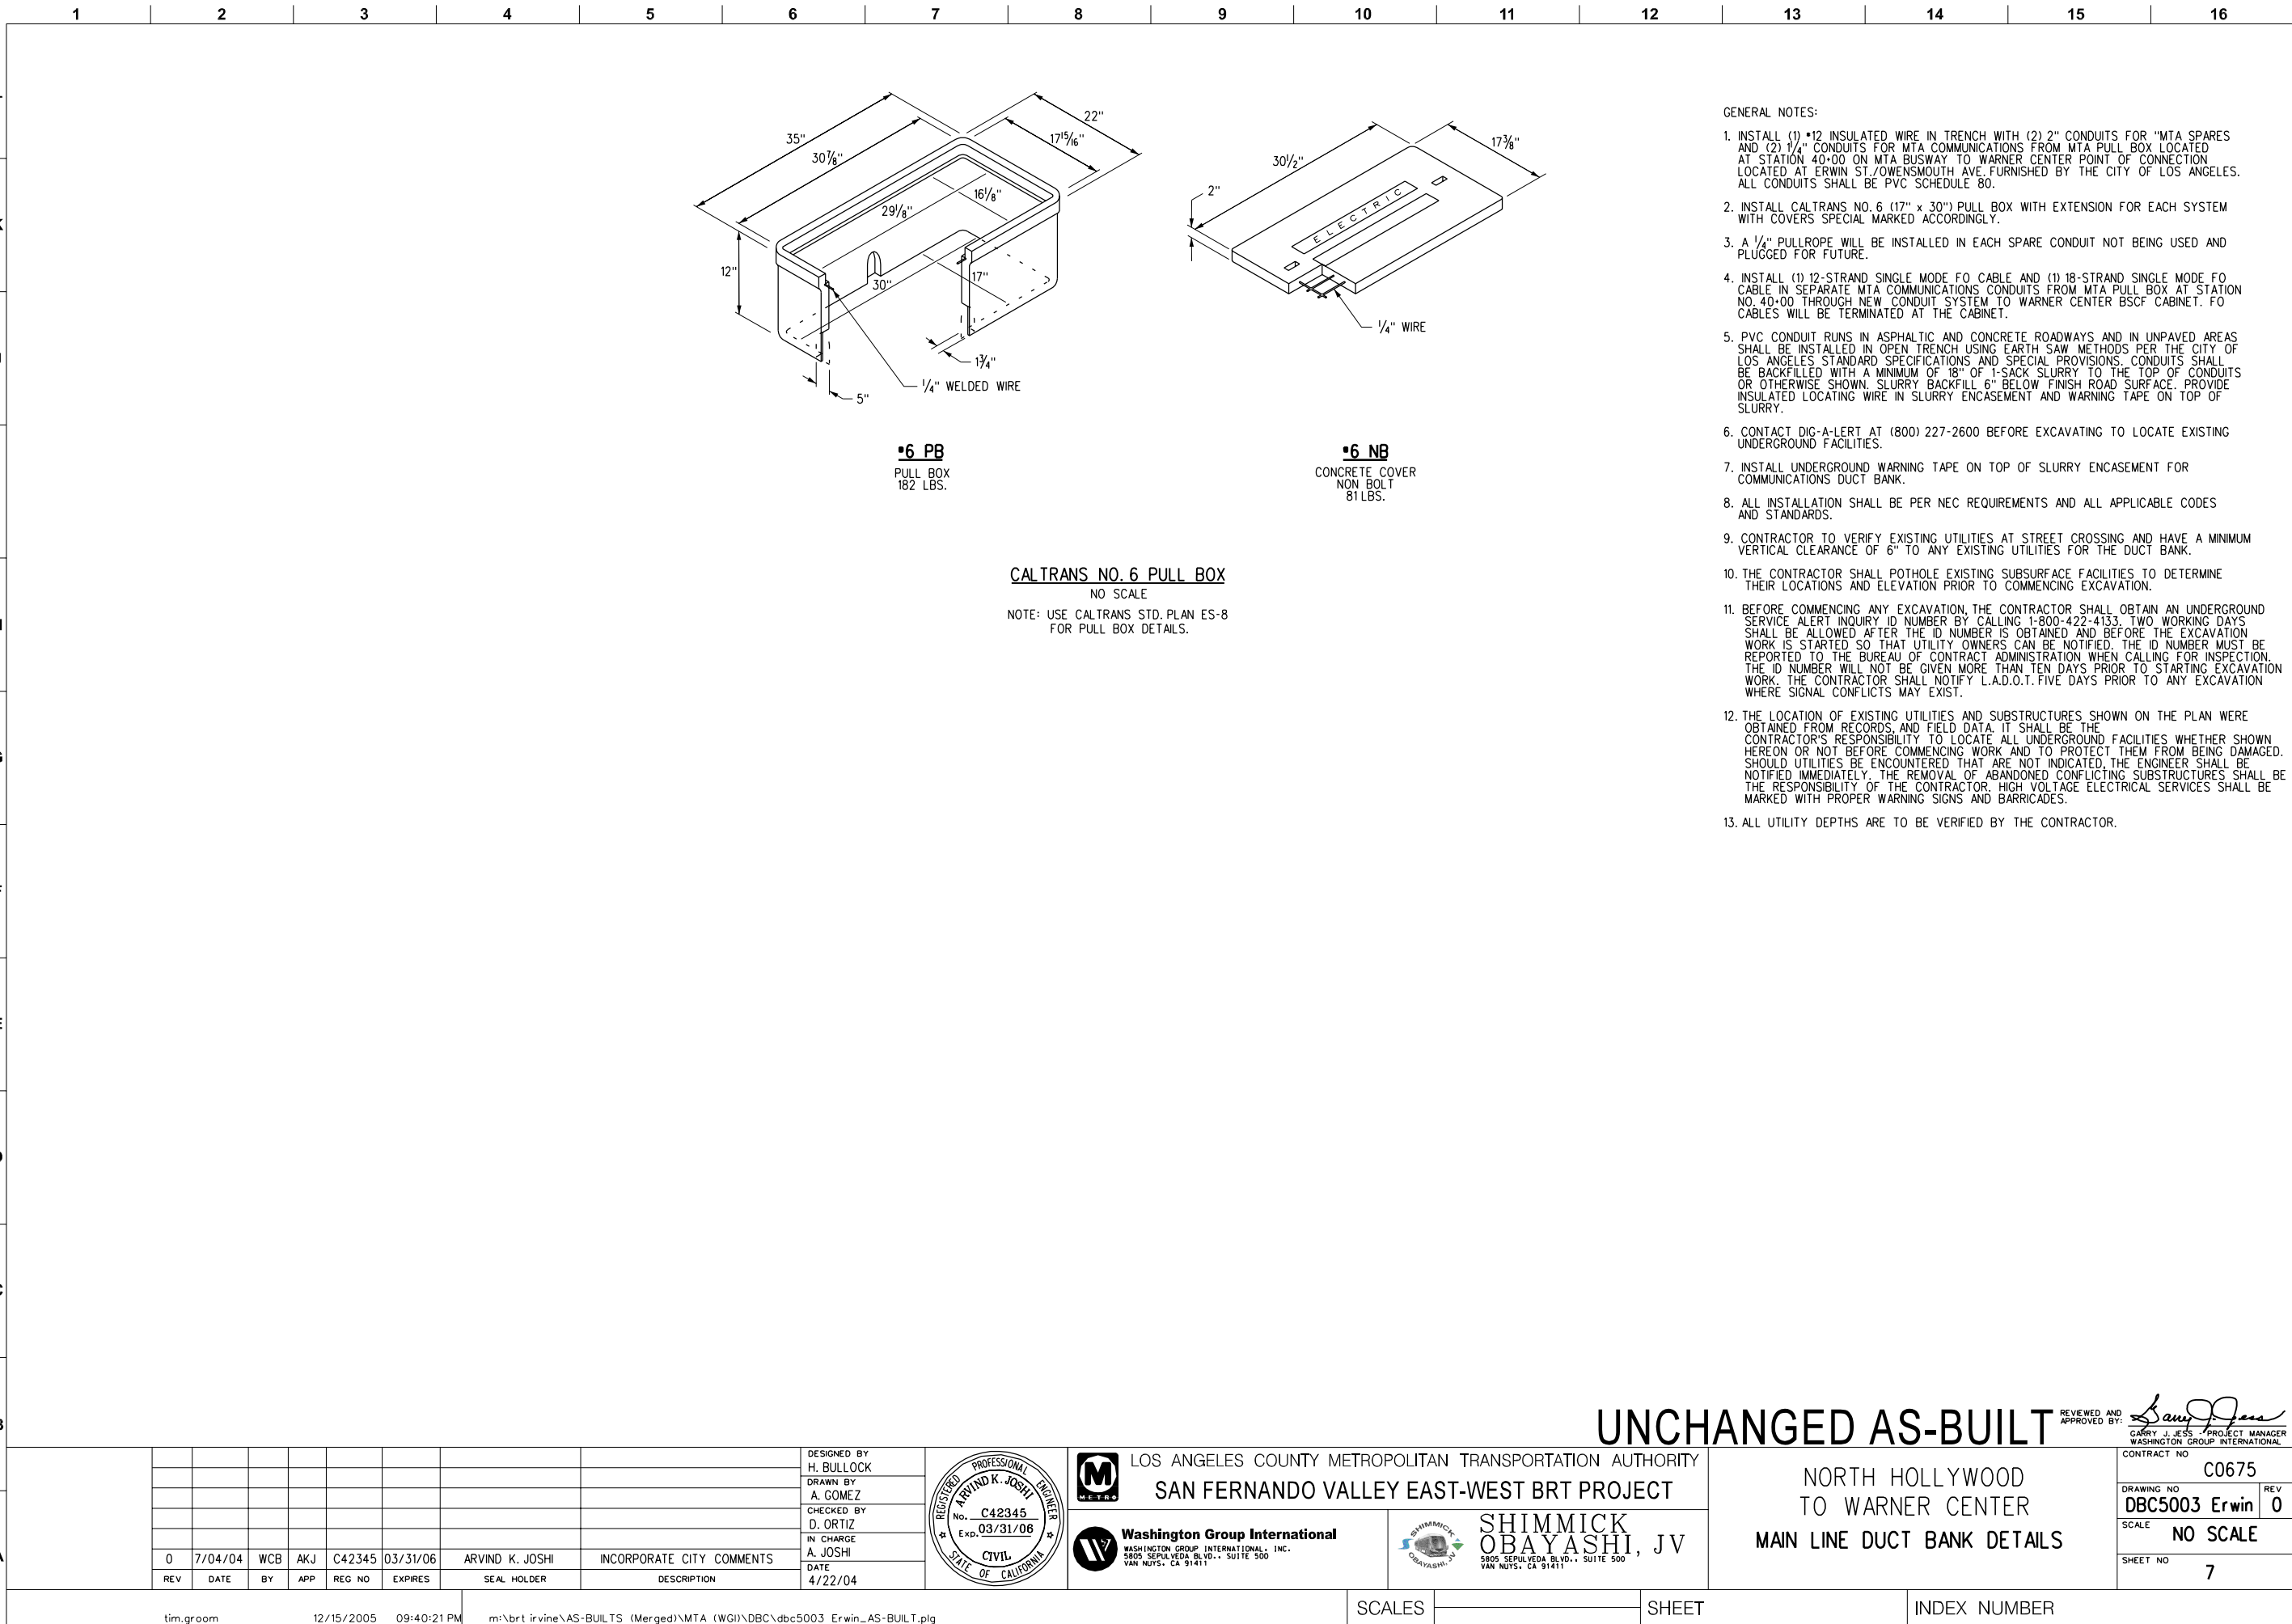

UNCHANGED AS-BUILT

REVIEWED AND APPROVED BY: *Garry J. Lee*
GARRY J. LEE, PROJECT MANAGER
WASHINGTON GROUP INTERNATIONAL

							DESIGNED BY H. BULLOCK			 LOS ANGELES COUNTY METROPOLITAN TRANSPORTATION AUTHORITY				NORTH HOLLYWOOD TO WARNER CENTER				CONTRACT NO C0675	
							DRAWN BY A. GOMEZ			SAN FERNANDO VALLEY EAST-WEST BRT PROJECT								DRAWING NO DBC5003 Erwin	
							CHECKED BY D. ORTIZ			 Washington Group International WASHINGTON GROUP INTERNATIONAL, INC. 5805 SEPULVEDA BLVD., SUITE 500 VAN NUYS, CA 91411				 SHIMMICK OBAYASHI, JV 5805 SEPULVEDA BLVD., SUITE 500 VAN NUYS, CA 91411				SCALE NO SCALE	
							IN CHARGE A. JOSHI											SHEET NO 7	
							DATE 4/22/04												
0	7/04/04	WCB	AKJ	C42345	03/31/06	ARVIND K. JOSHI	INCORPORATE CITY COMMENTS												
REV	DATE	BY	APP	REG NO	EXPIRES	SEAL HOLDER	DESCRIPTION												
tim.groom 12/15/2005 09:40:21 PM m:\brt\irvine\AS-BUILTS (Merged)\MTA (WGI)\DBC\dbc5003 Erwin_AS-BUILT.plg														SCALES		SHEET		INDEX NUMBER	

BUREAU OF ENGINEERING
DEPARTMENT OF PUBLIC WORKS
CITY OF LOS ANGELES

APPROVALS:	DATE:	BY:	REVISIONS:	DATE:	BY:
ST TREES DIV.	7/04/04	WCB	INCORPORATE CITY COMMENTS	7/04/04	WCB
ST LIGHTING	11/16/05	AU	AS-BUILT	11/16/05	AU
D.O.T.			WORK ACCEPTED		
			SERIAL NO.		
			B - PERMITS		
			INDEX NO.		

ACCEPTED BY:	DATE:
GARY LEE MOORE, P.E.	
PLAN CHECKER	DATE
DIVISION / DISTRICT ENGINEER	DATE

PROJECT:	PLAN:
SAN FERNANDO VALLEY	
EAST-WEST PROJECT	
ADDRESS:	

SHEET 7 OF 7 SHEETS
