


1" = 40'
SCALE IN FEET
0 10 20 30 40 80

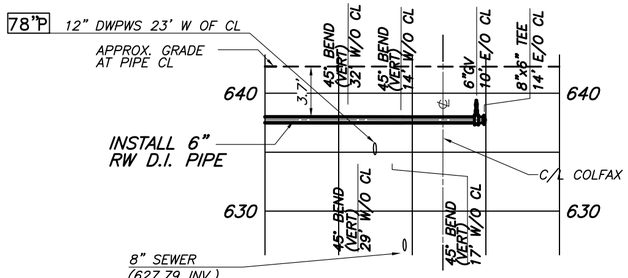


CHANDLER BLVD S. & COLFAX AVE.
SCALE: 1"=40' HORIZONTAL 1"=10' VERTICAL
AT 148+23

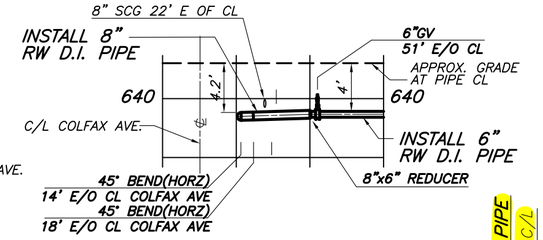


CHANDLER BLVD N. & COLFAX AVE.
SCALE: 1"=40' HORIZONTAL 1"=10' VERTICAL
AT 149+17

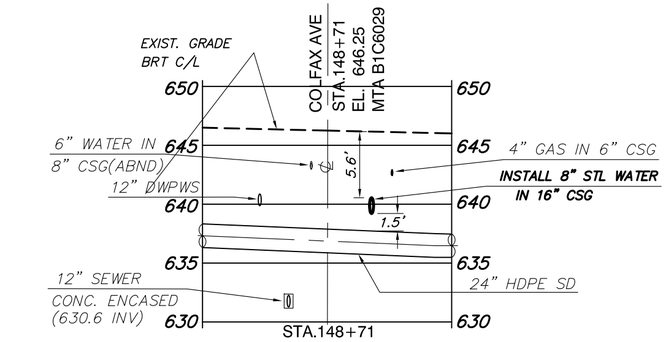

MTA STA. 148+71 ON COLFAX AVE. – SECTION C–C
SCALE: 1"=40' HORIZONTAL 1"=10' VERTICAL

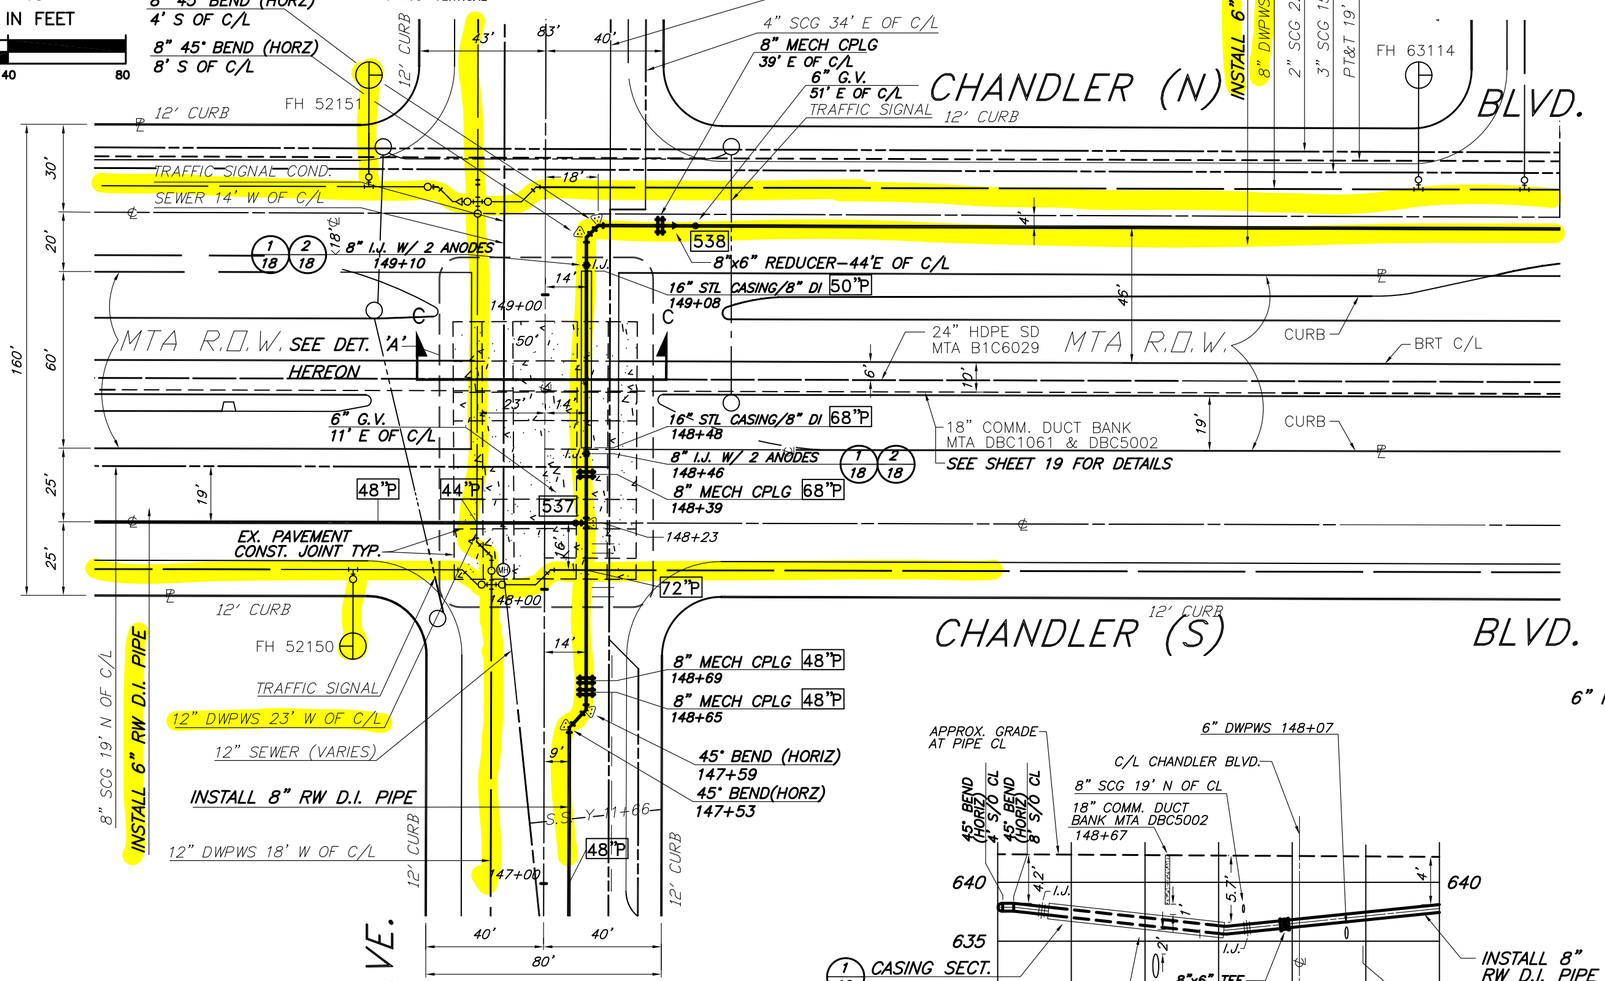

COLFAX AVE. & CHANDLER BLVD S.
SCALE: 1"=40' HORIZONTAL 1"=10' VERTICAL
AT 14' E/O CL

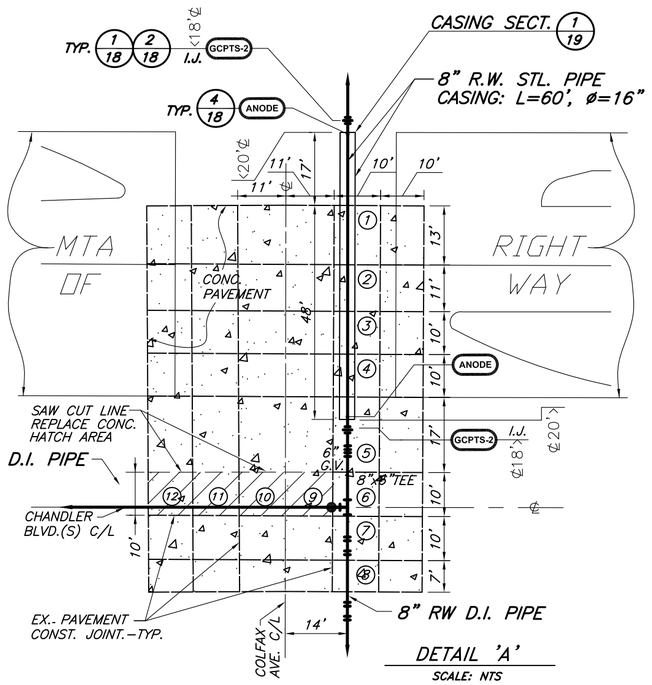

DETAIL 'A'
SCALE: NTS

PERMIT APPL.:	
WORK ORDER:	UDF36
TRACT NO.:	
SERVICE NO.:	
SERVICE NO.:	
GATE SECTION:	175–168
THOMAS GUIDE:	562–H2
W.S.M.:	172–168
MAX. STATIC PRESSURE(PSI)	
CORROSION INDEX	

BACKFILL: ☐ SAND ☐ NATIVE ☒ SLURRY

SUBS: ☒ S.D. ☒ S.S. ☒ GAS ☒ TEL. ☒ PWR. ☐ T.V. ☒ WTR. ☐ OIL ☒ T.S. ☒ S.L. ☒ MISC.

CITY OF LOS ANGELES
DEPARTMENT OF WATER AND POWER
P.O. BOX 51111, LOS ANGELES, CALIFORNIA 90051
WATER DISTRIBUTION BUSINESS UNIT
JOE CASTRUITA – DIRECTOR

DISTRICT: DISTRICT PHONE: PHONE

N. HOLLYWOOD RECYCLE WATER PROJECT – PHASE 3B
8" D.I. IN 16" STL CASING WITHIN MTA R/W

DRAWING COMPLETED		AS–BUILT COMPLETED	
DATE:	10/13/15	DATE:	4/13/18
DESIGNED:	DQ/RR/VVD	SUPV.:	JM/JG
APPROVED:	TH	SUPT.:	