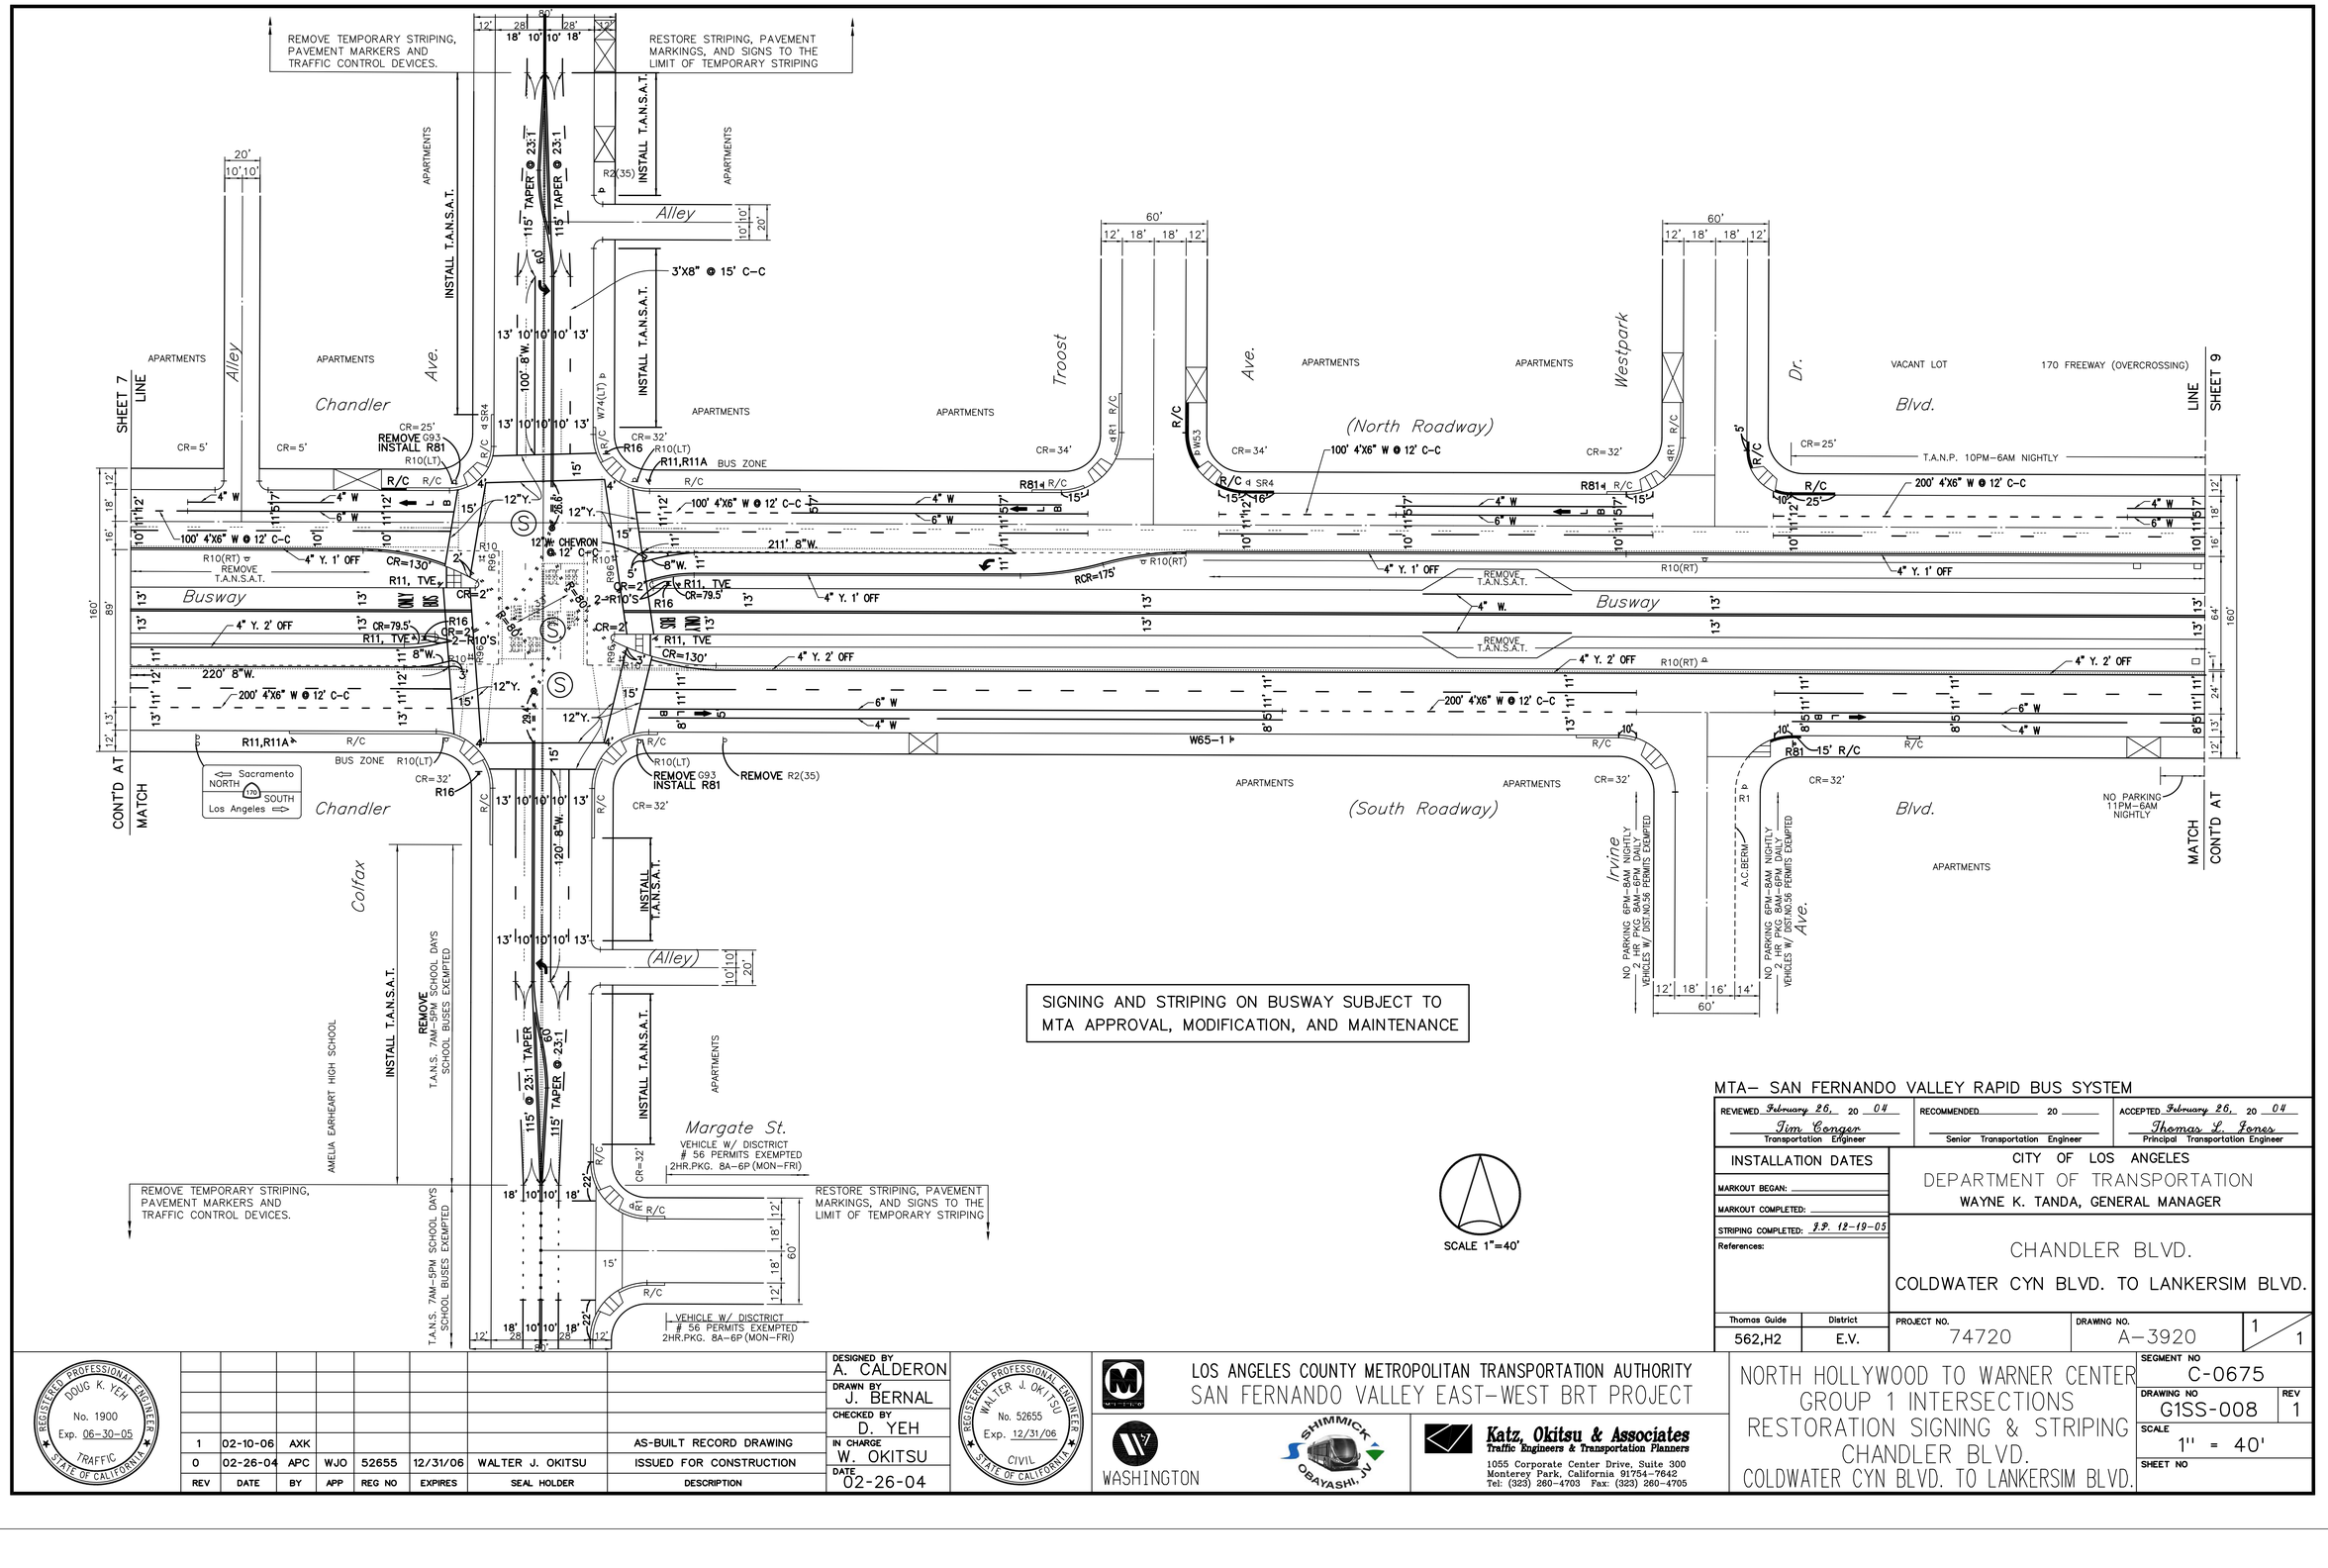

MTA– SAN FERNANDO VALLEY RAPID BUS SYSTEM

REVIEWED February 26, 20 04	RECOMMENDED ____ 20 ____	ACCEPTED February 26, 20 04
Jim Conger, Transportation Engineer	____, Senior Transportation Engineer	Thomas L. Jones, Principal Transportation Engineer

INSTALLATION DATES	CITY OF LOS ANGELES
MARKOUT BEGAN:	DEPARTMENT OF TRANSPORTATION
MARKOUT COMPLETED:	WAYNE K. TANDA, GENERAL MANAGER
STRIPING COMPLETED: J.P. 12-19-05	CHANDLER BLVD.
References:	COLDWATER CYN BLVD. TO LANKERSIM BLVD.

Thomas Guide	District	PROJECT NO.	DRAWING NO.	
562,H2	E.V.	74720	A-3920	1/1

REV	DATE	BY	APP	REG NO	EXPIRES	SEAL HOLDER	DESCRIPTION
1	02-10-06	AXK					AS-BUILT RECORD DRAWING
0	02-26-04	APC	WJO	52655	12/31/06	WALTER J. OKITSU	ISSUED FOR CONSTRUCTION

DESIGNED BY A. CALDERON
DRAWN BY J. BERNAL
CHECKED BY D. YEH
IN CHARGE W. OKITSU
DATE 02-26-04

REGISTERED PROFESSIONAL ENGINEER DOUG K. YEH No. 1900 Exp. 06-30-05 TRAFFIC STATE OF CALIFORNIA

REGISTERED PROFESSIONAL ENGINEER WALTER J. OKITSU No. 52655 Exp. 12/31/06 CIVIL STATE OF CALIFORNIA

LOS ANGELES COUNTY METROPOLITAN TRANSPORTATION AUTHORITY
SAN FERNANDO VALLEY EAST-WEST BRT PROJECT

WASHINGTON SHIMMICK OBAYASHI JV

Katz, Okitsu & Associates
Traffic Engineers & Transportation Planners
1055 Corporate Center Drive, Suite 300
Monterey Park, California 91754-7642
Tel: (323) 260-4703 Fax: (323) 260-4705

NORTH HOLLYWOOD TO WARNER CENTER
GROUP 1 INTERSECTIONS
RESTORATION SIGNING & STRIPING
CHANDLER BLVD.
COLDWATER CYN BLVD. TO LANKERSIM BLVD.

SEGMENT NO	C-0675	
DRAWING NO	G1SS-008	REV 1
SCALE	1" = 40'	
SHEET NO		