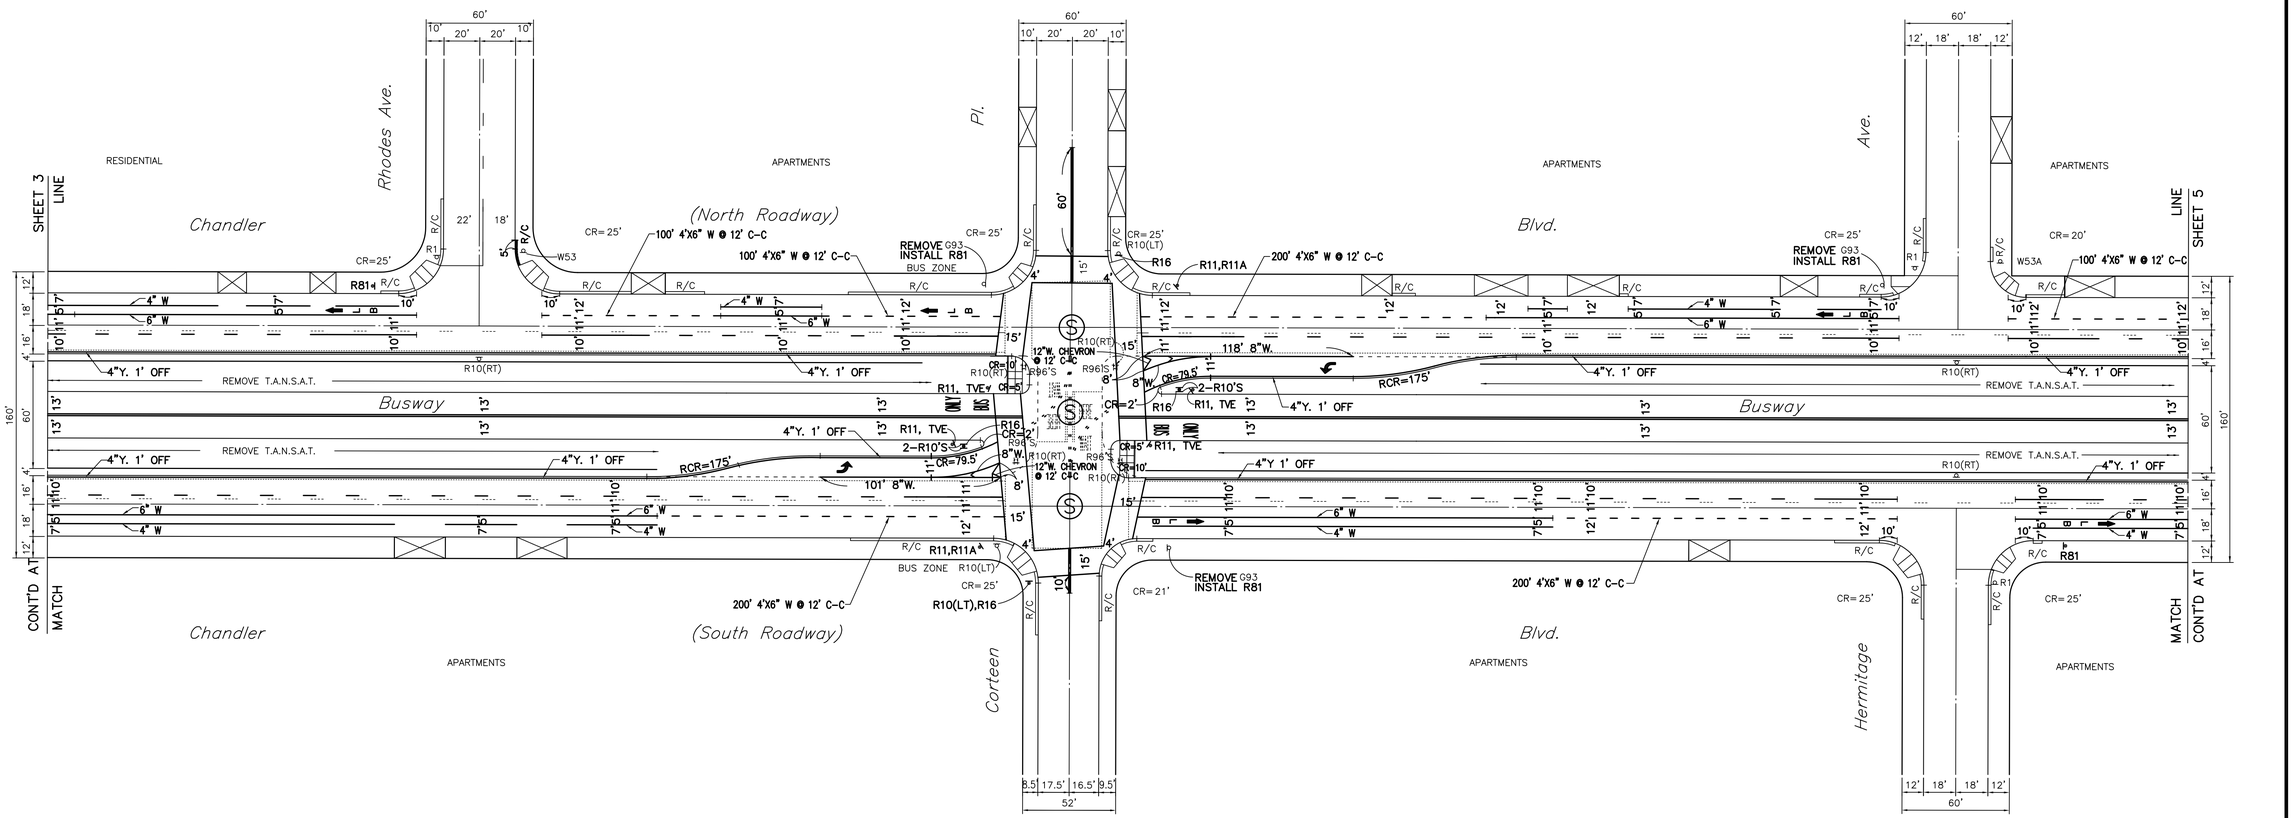

SCALE 1"=40'

SIGNING AND STRIPING ON BUSWAY SUBJECT TO MTA APPROVAL, MODIFICATION, AND MAINTENANCE

MTA– SAN FERNANDO VALLEY RAPID BUS SYSTEM

REVIEWED February 26, 20 04	RECOMMENDED 20	ACCEPTED February 26, 20 04
Jim Conger, Transportation Engineer	Senior Transportation Engineer	Thomas L. Jones, Principal Transportation Engineer

INSTALLATION DATES

MARKOUT BEGAN:

MARKOUT COMPLETED:

STRIPING COMPLETED: J.P. 12-19-05

References:

CITY OF LOS ANGELES
DEPARTMENT OF TRANSPORTATION
WAYNE K. TANDA, GENERAL MANAGER

CHANDLER BLVD.
COLDWATER CYN BLVD. TO LANKERSIM BLVD.

Thomas Guide	District	PROJECT NO.	DRAWING NO.	
562,F2	E.V.	74720	A–3920	1 / 1

REGISTERED PROFESSIONAL ENGINEER — DOUG K. YEH — No. 1900 — Exp. 06–30–05 — TRAFFIC — STATE OF CALIFORNIA

REV	DATE	BY	APP	REG NO	EXPIRES	SEAL HOLDER	DESCRIPTION
1	02-10-06	AXK					AS-BUILT RECORD DRAWING
0	02-26-04	APC	WJO	52655	12/31/06	WALTER J. OKITSU	ISSUED FOR CONSTRUCTION

DESIGNED BY A. CALDERON
DRAWN BY J. BERNAL
CHECKED BY D. YEH
IN CHARGE W. OKITSU
DATE 02-26-04

REGISTERED PROFESSIONAL ENGINEER — WALTER J. OKITSU — No. 52655 — Exp. 12/31/06 — CIVIL — STATE OF CALIFORNIA

LOS ANGELES COUNTY METROPOLITAN TRANSPORTATION AUTHORITY
SAN FERNANDO VALLEY EAST–WEST BRT PROJECT

WASHINGTON SHIMMICK OBAYASHI JV

Katz, Okitsu & Associates
Traffic Engineers & Transportation Planners
1055 Corporate Center Drive, Suite 300
Monterey Park, California 91754–7642
Tel: (323) 260–4703 Fax: (323) 260–4705

NORTH HOLLYWOOD TO WARNER CENTER
GROUP 1 INTERSECTIONS
RESTORATION SIGNING & STRIPING
CHANDLER BLVD.
COLDWATER CYN BLVD. TO LANKERSIM BLVD.

SEGMENT NO C-0675
DRAWING NO G1SS-004 REV 1
SCALE 1" = 40'
SHEET NO