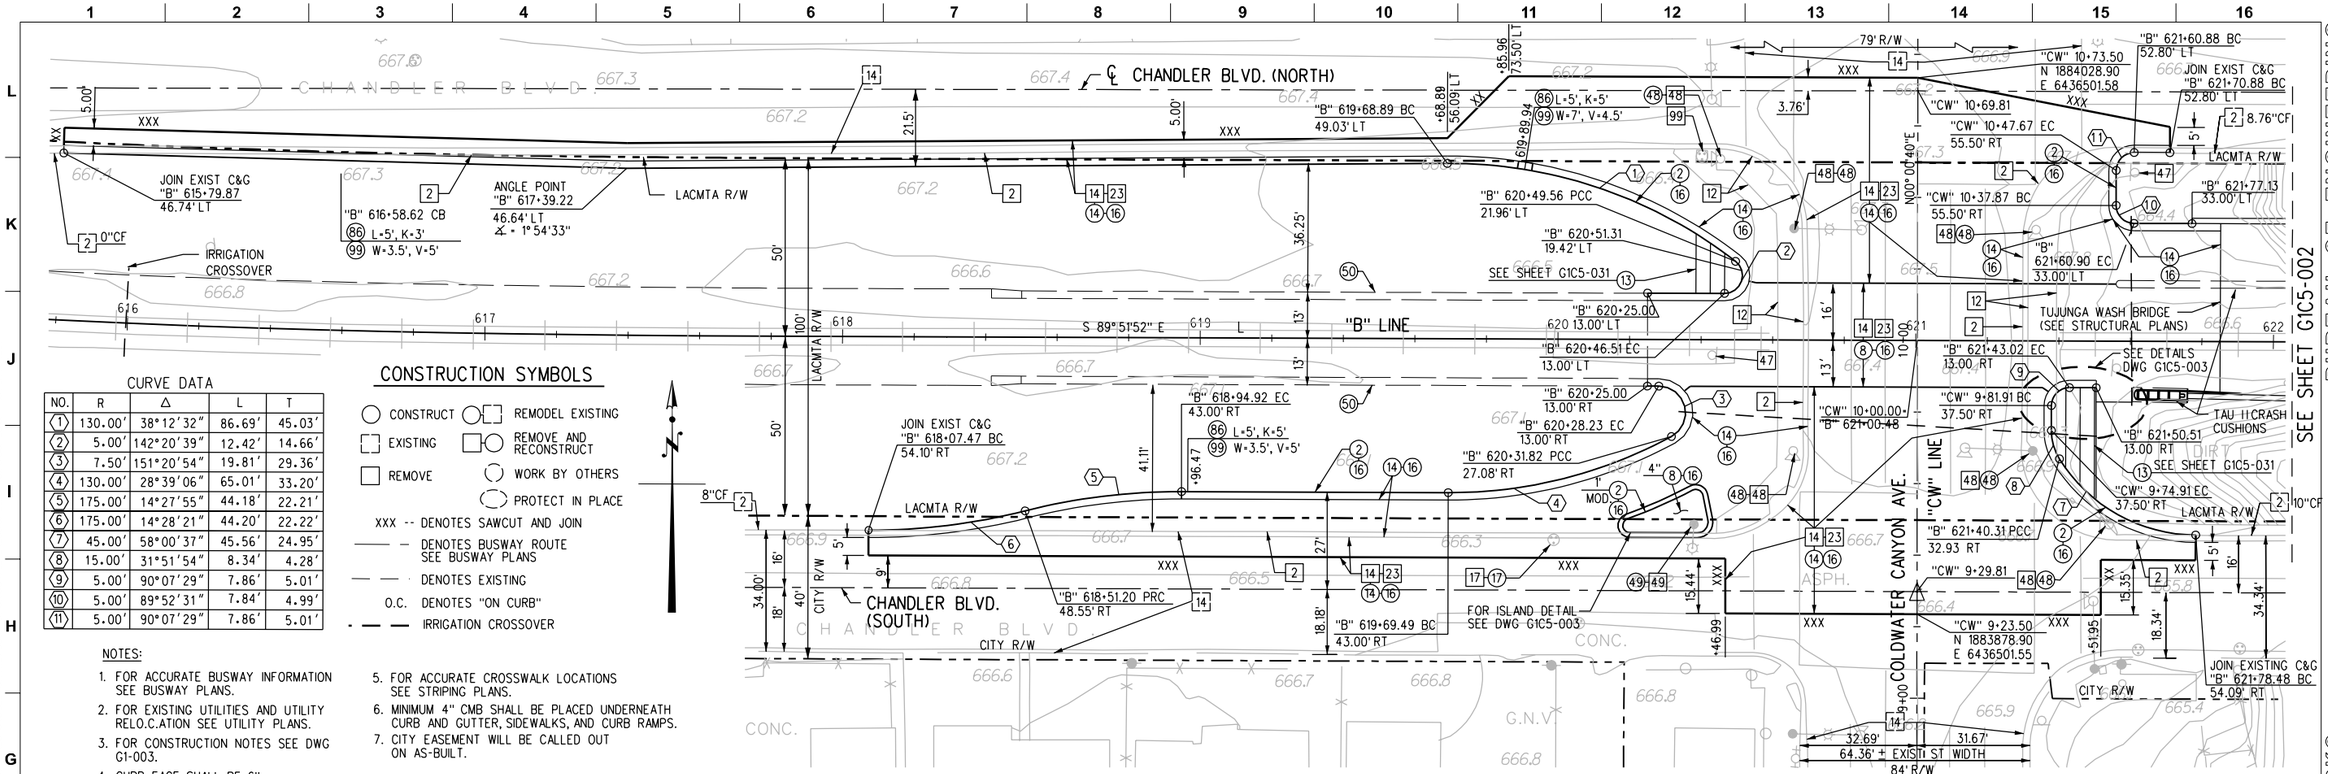


CURVE DATA


NO.	R	Δ	L	T
1	130.00'	38°12'32"	86.69'	45.03'
2	5.00'	142°20'39"	12.42'	14.66'
3	7.50'	151°20'54"	19.81'	29.36'
4	130.00'	28°39'06"	65.01'	33.20'
5	175.00'	14°27'55"	44.18'	22.21'
6	175.00'	14°28'21"	44.20'	22.22'
7	45.00'	58°00'37"	45.56'	24.95'
8	15.00'	31°51'54"	8.34'	4.28'
9	5.00'	90°07'29"	7.86'	5.01'
10	5.00'	89°52'31"	7.84'	4.99'
11	5.00'	90°07'29"	7.86'	5.01'


CONSTRUCTION SYMBOLS

- CONSTRUCT
- EXISTING
- REMOVE
- REMODEL EXISTING
- REMOVE AND RECONSTRUCT
- WORK BY OTHERS
- PROTECT IN PLACE
- XXX -- DENOTES SAWCUT AND JOIN
- —— — DENOTES BUSWAY ROUTE SEE BUSWAY PLANS
- — — DENOTES EXISTING
- O.C. DENOTES "ON CURB"
- — — IRRIGATION CROSSOVER

NOTES:

1. FOR ACCURATE BUSWAY INFORMATION SEE BUSWAY PLANS.
2. FOR EXISTING UTILITIES AND UTILITY RELO.C.ATION SEE UTILITY PLANS.
3. FOR CONSTRUCTION NOTES SEE DWG G1-003.
4. CURB FACE SHALL BE 6" UNLESS OTHERWISE NOTED
5. FOR ACCURATE CROSSWALK LOCATIONS SEE STRIPING PLANS.
6. MINIMUM 4" CMB SHALL BE PLACED UNDERNEATH CURB AND GUTTER, SIDEWALKS, AND CURB RAMPS.
7. CITY EASEMENT WILL BE CALLED OUT ON AS-BUILT.

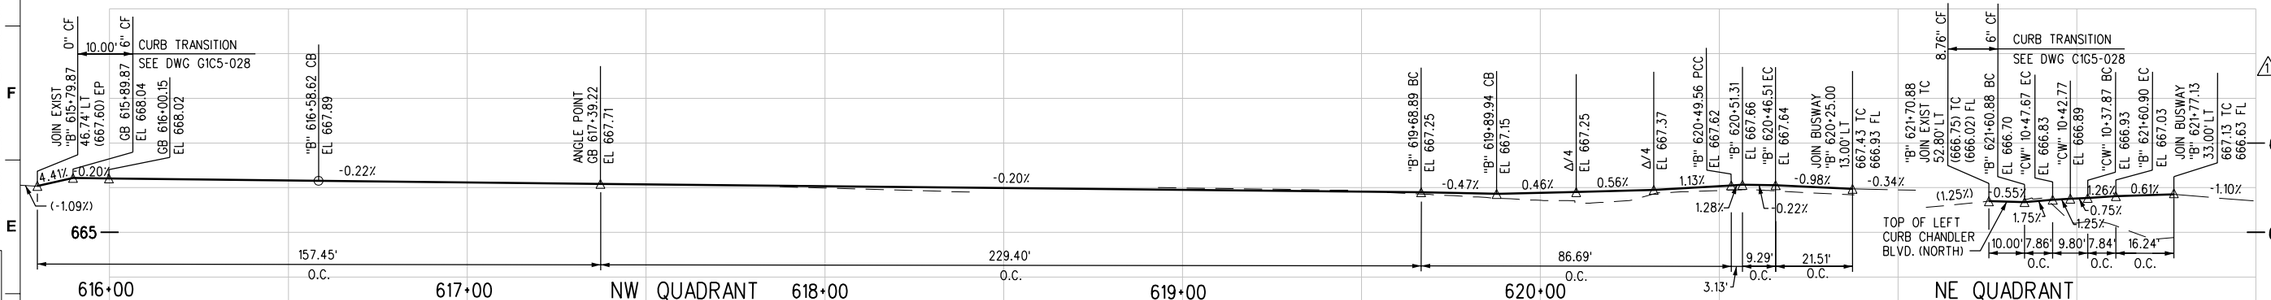

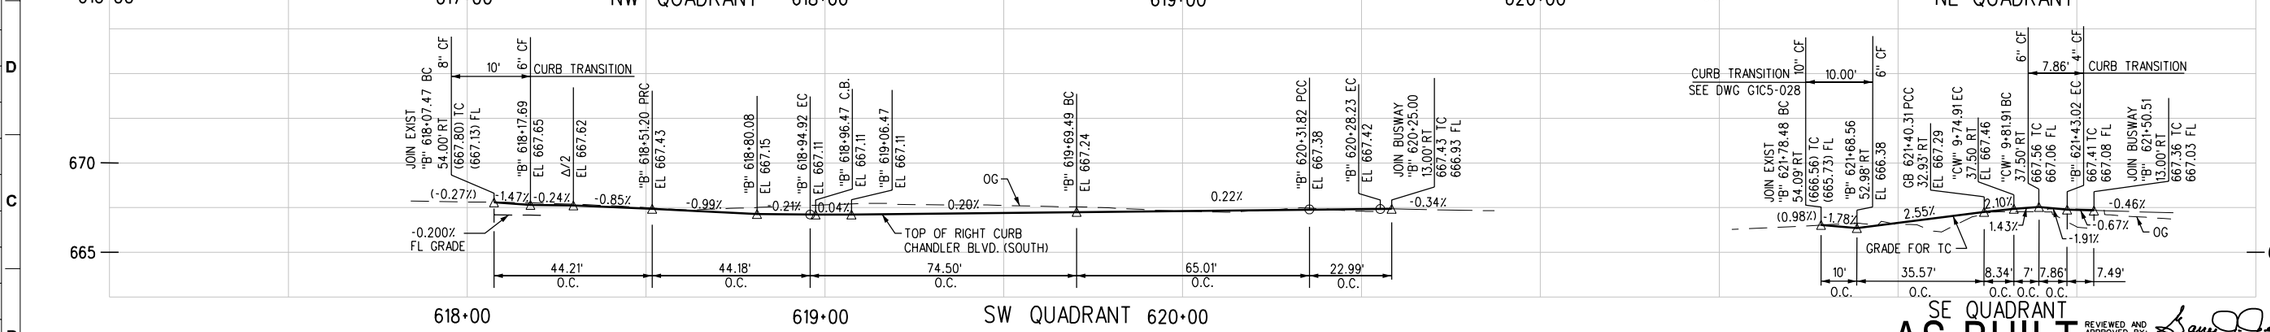

SE QUADRANT

AS-BUILT

REVIEWED AND APPROVED BY:

GARRY J. JESS - PROJECT MANAGER
WASHINGTON GROUP INTERNATIONAL

REV	DATE	BY	APP	REG NO	EXPIRES	SEAL HOLDER	DESCRIPTION
1	11/2/04	AJ	CC	C42345	03/31/06	ARVIND K. JOSHI	ISSUED FOR CONSTRUCTION
0	1/23/04	FA	CC	49987	12/31/05	FRANCISCO G. ALCARAZ	ISSUED FOR CONSTRUCTION

REVISION DATES (DESIGN STAGE ONLY)

DESIGNED BY H. BARKHORDARIAN
DRAWN BY H. BARKHORDARIAN
CHECKED BY J. R. VALLE
IN CHARGE A. JOSHI
DATE 12/01/03

REGISTERED PROFESSIONAL ENGINEER — ARVIND K. JOSHI — No. C42345 — Exp. 03/31/06 — CIVIL — STATE OF CALIFORNIA

LOS ANGELES COUNTY METROPOLITAN TRANSPORTATION AUTHORITY
SAN FERNANDO VALLEY EAST-WEST BRT PROJECT

Washington Group International
WASHINGTON GROUP INTERNATIONAL, INC.
5805 SEPULVEDA BLVD., SUITE 500
VAN NUYS, CA 91411

SHIMMICK OBAYASHI, JV
5805 SEPULVEDA BLVD., SUITE 500
VAN NUYS, CA 91411

STREET IMPROVEMENTS GROUP 1
PLAN AND PROFILE
CHANDLER BLVD. AT COLDWATER CANYON AVE.
SHEET 1 OF 2

CONTRACT NO C0675
DRAWING NO G1C5-001 REV 1
SCALE HORIZ SCALE: 1"=20' VERT SCALE: 1"=4'
SHEET NO

tim.groom 12/15/2005 01:00:07 PM m:\brt irvine\AS-BUILTS (Merged)\LABOE (WGI)\G1\g1c5-001_AS-BUILT.plg

HORIZONTAL GRAPHIC SCALE 20' 10' 0 20' 40'
VERTICAL GRAPHIC SCALE 4' 1' 0 4' 8'

SCALES HORIZ SCALE: 1"=20' VERT SCALE: 1"=4'
SHEET
INDEX NUMBER

CITY OF LOS ANGELES DEPARTMENT OF PUBLIC WORKS BUREAU OF ENGINEERING

LA DPW ENGINEERING Standards Present, Sustainable Future

NO.	REVISIONS:	DATE:	BY:
0	ISSUED FOR CONSTRUCTION	1/23/04	FA
1	ISSUED FOR CONSTRUCTION	11/2/04	AJ
2	AS-BUILT	9/6/05	TG
	WORK ACCEPTED	SERIAL NO.	

B - PERMITS BD/BC

INDEX NO.

APPROVALS: DATE: BY:
ST. TREES DIV.
ST. LIGHTING
D.O.T.

VERTICAL CONTROL: NAVD88, 1988 ADJ
HORIZONTAL CONTROL: NAD83, EPOCH 1995.0

SHEET TITLE: PLANS
PROJECT: SAN FERNANDO VALLEY EAST-WEST PROJECT
ADDRESS:

GARY LEE MOORE, P.E. CITY ENGINEER
ACCEPTED BY:
PLAN CHECKER DATE
DIVISION / DISTRICT ENGINEER DATE

PROJECT NO.
DRAWING NO. 1
SHEET 1 OF 32 SHEETS

THE CITY OF LOS ANGELES OR ITS OFFICERS OR AGENTS SHALL NOT BE RESPONSIBLE FOR THE ACCURACY OR COMPLETENESS OF ELECTRONIC COPIES OF THIS PLAN SHEET.

Sheet Version 2.01