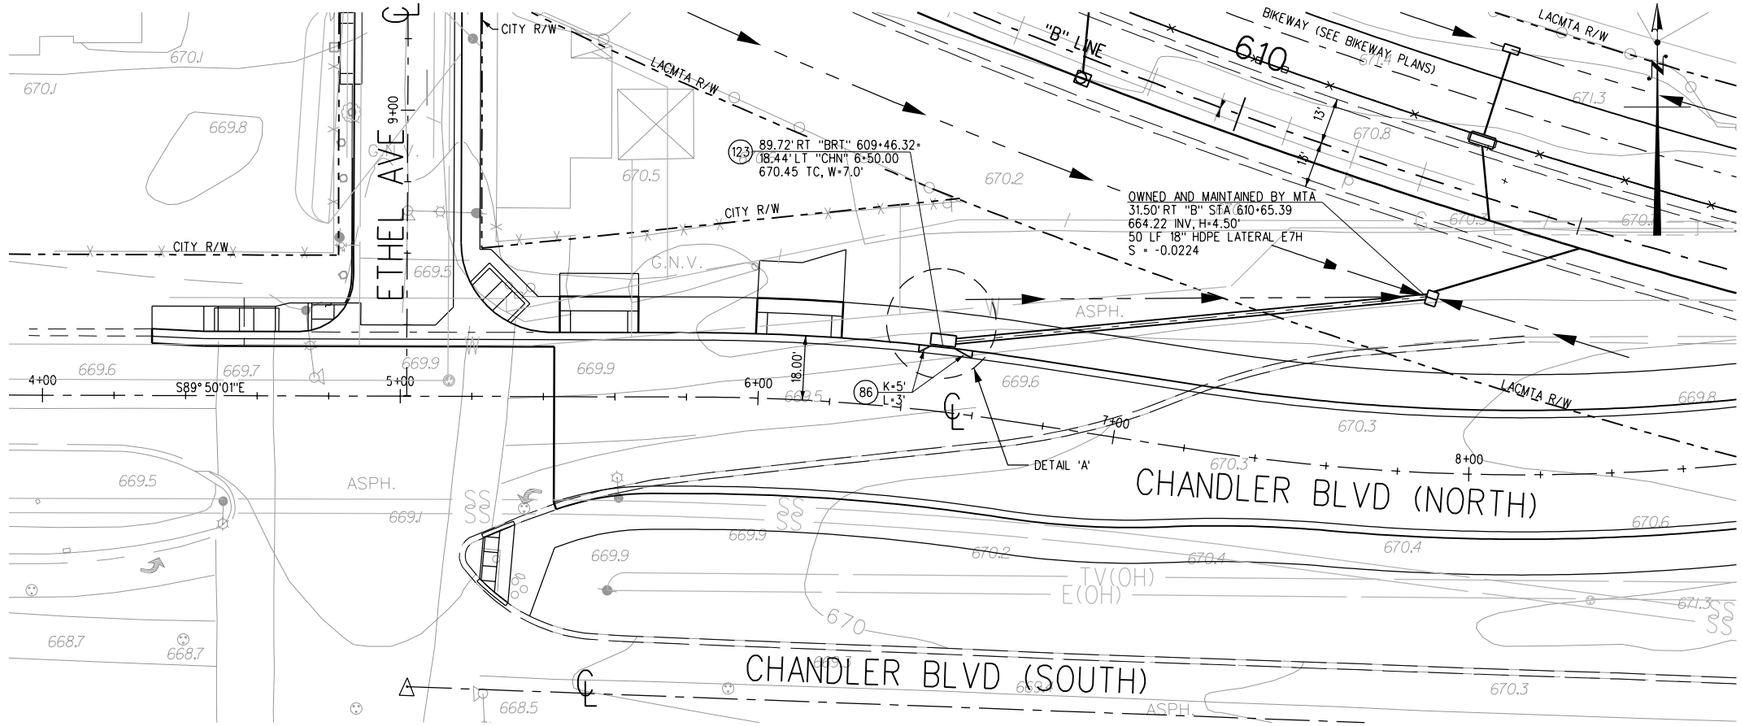

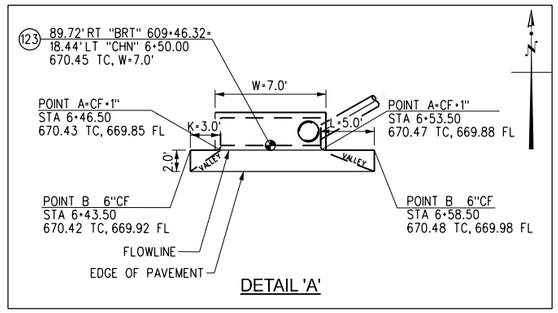

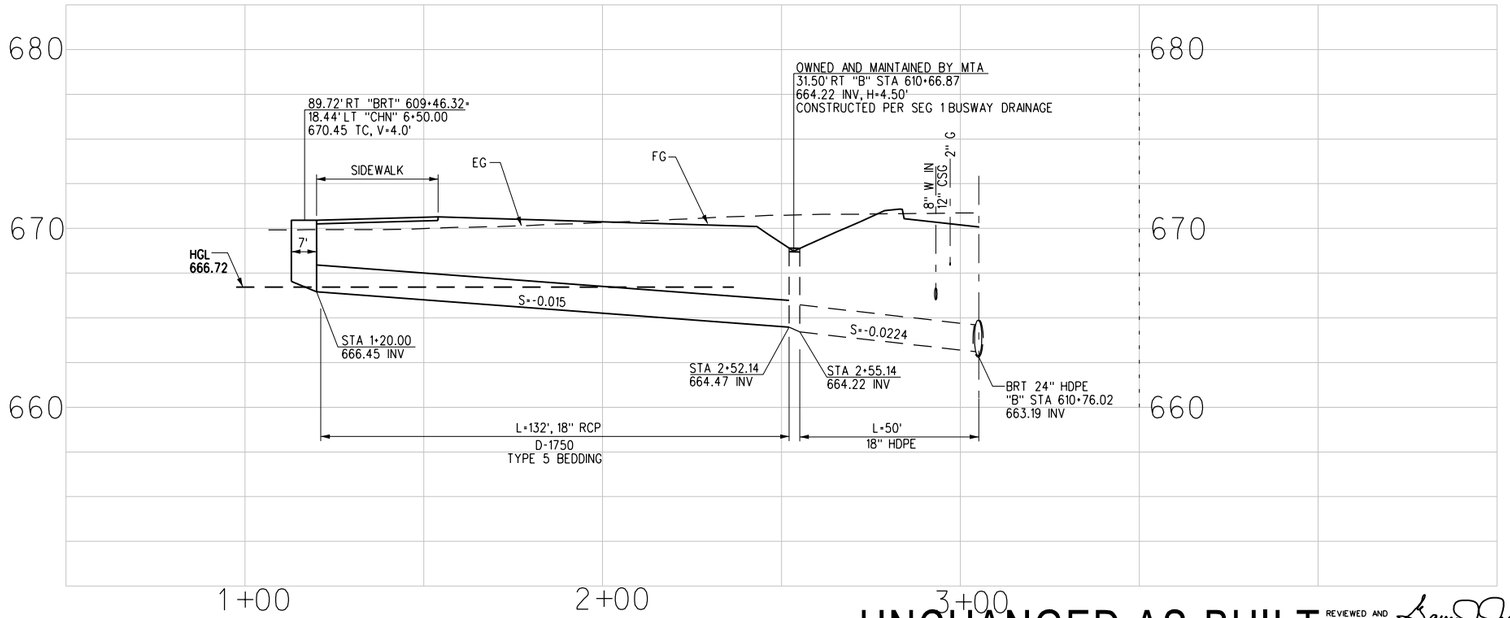

CONSTRUCTION SYMBOLS

- CONSTRUCT
- EXISTING
- REMOVE
- REMODEL EXISTING
- REMOVE AND RECONSTRUCT
- WORK BY OTHERS
- PROTECT IN PLACE

XXX -- DENOTES SAWCUT AND JOIN
O.C. -- DENOTES "ON CURB"
DENOTES BUSWAY ROUTE SEE BUSWAY PLANS
DENOTES EXISTING

UNCHANGED AS-BUILT

REVIEWED AND APPROVED BY: GARRY J. JESS - PROJECT MANAGER WASHINGTON GROUP INTERNATIONAL

REV	DATE	BY	APP	REG NO	EXPIRES	SEAL HOLDER	DESCRIPTION
0	6/14/04	HAB	AKJ	C42345	06/30/05	ARVIND K. JOSHI	ISSUED FOR CONSTRUCTION

DESIGNED BY H. BULLOCK
DRAWN BY A. GOMEZ
CHECKED BY D. ORTIZ
IN CHARGE A. JOSHI
DATE 04-22-04

REGISTERED PROFESSIONAL ENGINEER — ARVIND K. JOSHI — No. C42345 — Exp. 03/31/06 — CIVIL — STATE OF CALIFORNIA

LOS ANGELES COUNTY METROPOLITAN TRANSPORTATION AUTHORITY
SAN FERNANDO VALLEY EAST-WEST BRT PROJECT

Washington Group International
WASHINGTON GROUP INTERNATIONAL, INC.
5805 SEPULVEDA BLVD., SUITE 500
VAN NUYS, CA 91411

SHIMMICK OBAYASHI, JV
5805 SEPULVEDA BLVD., SUITE 500
VAN NUYS, CA 91411

STREET IMPROVEMENTS GROUP 5
STORM DRAIN PLAN AND PROFILE
CHANDLER BLVD (NORTH)
EAST OF ETHEL AVE

CONTRACT NO C0675
DRAWING NO G5C6-004 REV 0
SCALE HORIZ. SCALE: 1"=20' VERT. SCALE: 1"=4'
SHEET NO

tim.groom 12/15/2005 04:35:03 PM m:\brt irvine\AS-BUILTS (Merged)\LABOE (WGI)\G5\g5c6-004_AS-BUILT.plt

HORIZONTAL GRAPHIC SCALE 20' 10' 0 20' 40'
VERTICAL GRAPHIC SCALE 4' 1' 0 4' 8'

SCALES HORIZ. SCALE: 1"=20' VERT. SCALE: 1"=4'
SHEET
INDEX NUMBER

REVISION DATES (DESIGN STAGE ONLY)

THE CITY OF LOS ANGELES OR ITS OFFICERS OR AGENTS SHALL NOT BE RESPONSIBLE FOR THE ACCURACY OR COMPLETENESS OF ELECTRONIC COPIES OF THIS PLAN SHEET.

Sheet Version 2.01

CITY OF LOS ANGELES DEPARTMENT OF PUBLIC WORKS BUREAU OF ENGINEERING

LA DPW ENGINEERING Standards Present, Sustainable Future

V.NO.	REVISIONS:	DATE:	BY:
0	ISSUED FOR CONSTRUCTION	6/14/04	HAB
1	AS-BUILT	11/29/05	WJ
	SERIAL NO.		
	WORK ACCEPTED		

B - PERMITS
BD/BC
INDEX NO.

APPROVALS: DATE: BY:
ST. TREES DIV.
ST. LIGHTING
D.O.T.

CITY ENGINEER
GARY LEE MOORE, P.E.
ACCEPTED BY: DATE
PLAN CHECKER DATE
DIVISION / DISTRICT ENGINEER

VERTICAL CONTROL: NAVD88, 1988 ADJ
HORIZONTAL CONTROL: NAD83, EPOCH 1.9956.0

SHEET TITLE: PLANS
PROJECT: SAN FERNANDO VALLEY EAST-WEST PROJECT
ADDRESS:

PROJECT NO.
DRAWING NO. 4
SHEET 4 OF 8 SHEETS