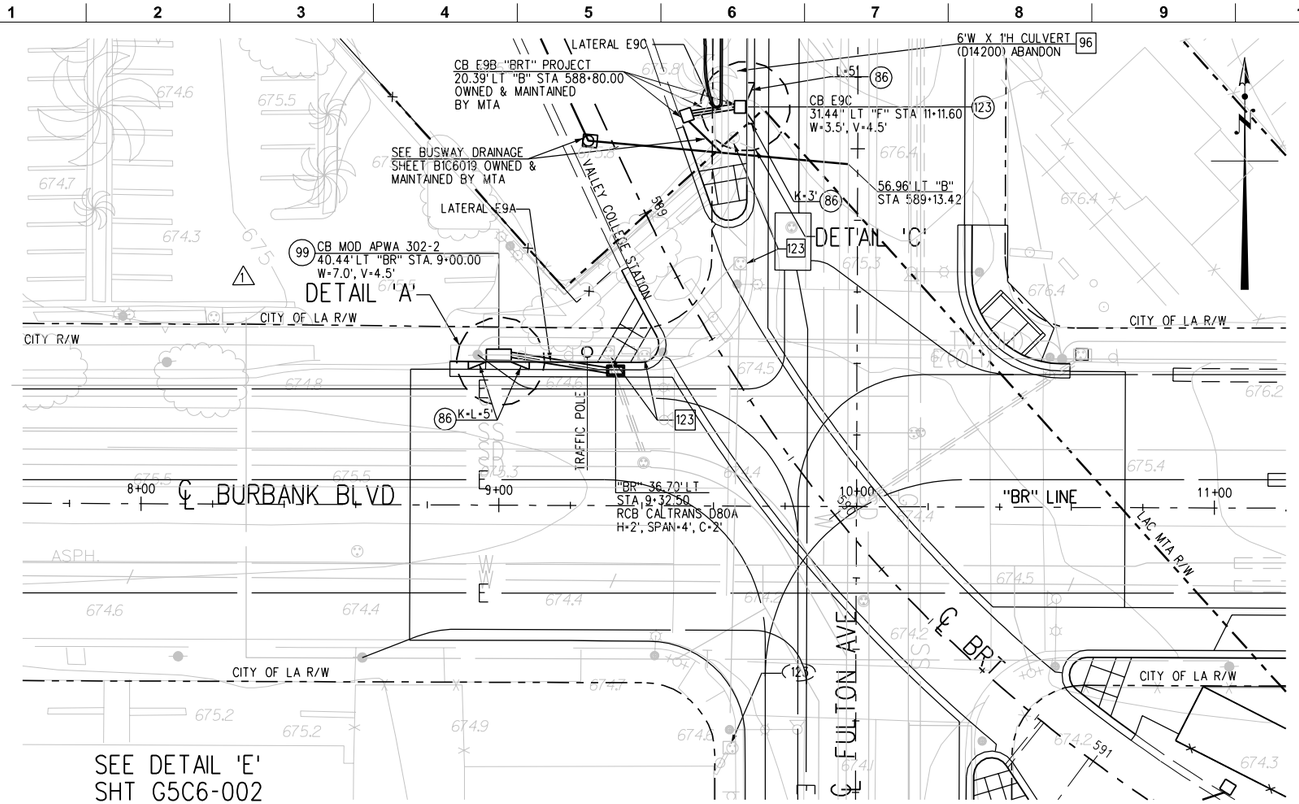

NOTES:

1. THE BRT PROJECT DATUM IS NAVD '88 WHICH IN THIS VICINITY IS APPROXIMATELY 2.22' HIGHER THAN LACFCD PROJECT NO. 9203.

CONSTRUCTION SYMBOLS

- CONSTRUCT
- EXISTING
- REMOVE
- REMODEL EXISTING
- REMOVE AND RECONSTRUCT
- WORK BY OTHERS
- PROTECT IN PLACE
- XXX — DENOTES SAWCUT AND JOIN
- —— —— DENOTES BUSWAY ROUTE SEE BUSWAY PLANS
- — — — DENOTES EXISTING

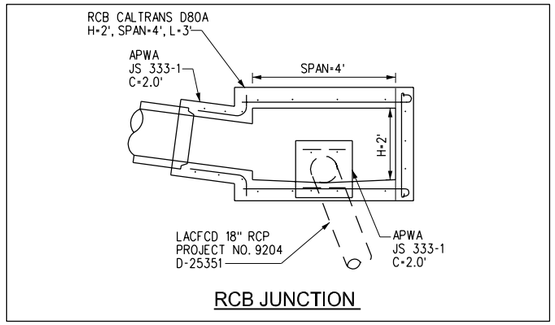

RCB JUNCTION

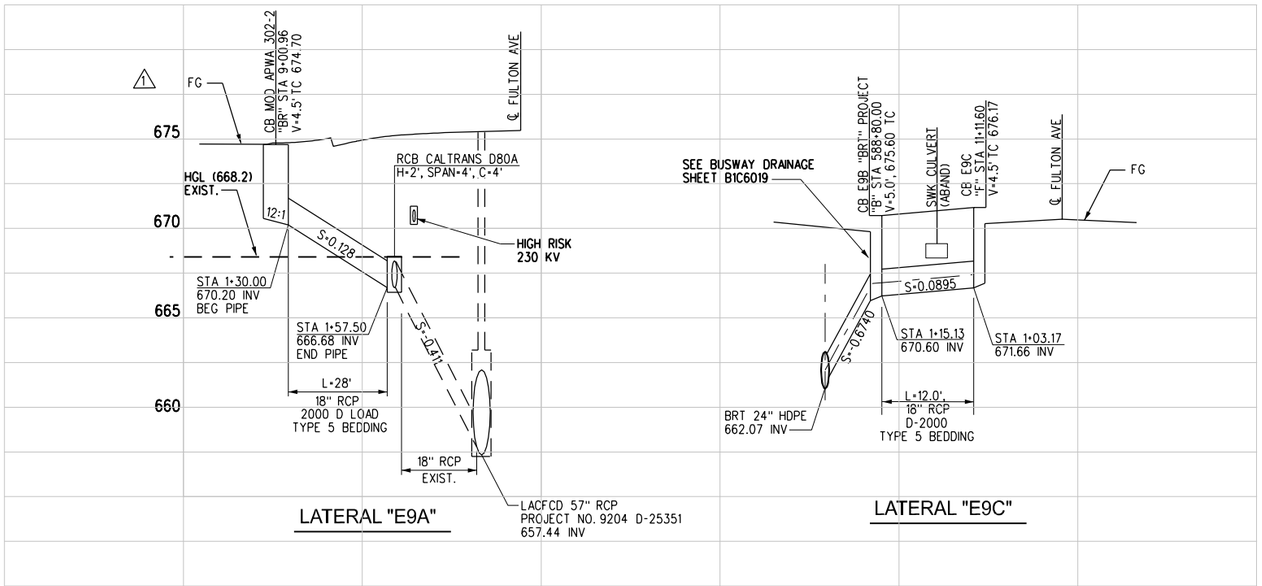

CONCRETE REMOVAL NOTES

A. WHERE A SECTION OF AN EXISTING STRUCTURE IS TO BE SEPARATED FROM A NEW STRUCTURE, AND THE REINFORCEMENT IS TO BE CUT AT THE POINT OF SEPARATION, THE CONTRACTOR SHALL SAWCUT THROUGH THE WALL WITH AN APPROVED CONCRETE SAW. ANY SAW CUT OR IRREGULARITIES IN THE SURFACE OF THE REMAINING WALL OR JOINT SHALL BE FILLED WITH AN EPOXY GROUT MIXTURE TO OBTAIN A SMOOTH PLANE SURFACE. THE REINFORCING STEEL EXPOSED BY CONCRETE REMOVAL SHALL BE BURNED OFF ONE (1) INCH BELOW THE SURFACE OF THE REMAINING CONCRETE AND THE RESULTING VOIDS SHALL BE PATCHED WITH EPOXY ADHESIVE. EPOXY SHALL BE A COMMERCIAL QUALITY, TWO-COMPONENT MIXTURE, SPECIALLY MANUFACTURED FOR THE INTENDED PURPOSE, AND BE APPLIED IN ACCORDANCE WITH THE MANUFACTURER'S DIRECTIONS. ONE-HALF INCH THICK PREMOLDED EXPANSION JOINT MATERIAL SHALL BE USED TO SEPARATE THE FACES OF THE EXISTING AND NEW WALL.

B. WHERE REINFORCEMENT IS REQUIRED TO EXTEND THROUGH THE NEW JOINT, CONCRETE SHALL BE REMOVED IN THE FOLLOWING SEQUENCE.

1. A SAWCUT SHALL BE MADE ONE AND ONE-HALF INCHES DEEP AT THE REMOVAL LIMITS. CARE SHALL BE EXERCISED IN SAWING AT THE REMOVAL LIMITS SO AS NOT TO CUT THE REINFORCING STEEL IN THE REMAINING SLAB. THE EXISTING REINFORCING STEEL SHALL BE RETAINED AND EXTENDED INTO THE NEW CONSTRUCTION AS INDICATED ON THE PLANS.

2. USING HANDHELD EQUIPMENT, THE CONCRETE SHALL BE CAREFULLY REMOVED FOR THE FULL DEPTH OF THE WALL OR SLAB AND FOR A MINIMUM DISTANCE FORM THE SAWCUT EQUAL TO THE LONGEST EXTENSION OF THE EXISTING BARS TO BE EXTENDED INTO THE NEW CONSTRUCTION. THIS EXTENSION SHALL BE 30 BAR DIAMETERS, UNLESS OTHERWISE SHOWN.

3. EXISTING REINFORCEMENT SHALL BE CUT TO THE REQUIRED BAR EXTENSION.

4. THE REMAINING CONCRETE MAY BE REMOVED BY ANY SUITABLE METHOD UPON APPROVAL OF THE ENGINEER, WHO SHALL BE THE SOLE JUDGE OF THE USE OF ANY CONCRETE REMOVAL EQUIPMENT. EXPLOSIVES, WRECKING BALL, OR OTHER SIMILAR DEVICES, WHICH ARE LIKELY TO DAMAGE THE CONCRETE TO BE LEFT IN PLACE, SHALL NOT BE USED.

AS-BUILT

REVIEWED AND APPROVED BY: GARRY J. JESS - PROJECT MANAGER WASHINGTON GROUP INTERNATIONAL

REV	DATE	BY	APP	REG NO	EXPIRES	SEAL HOLDER	DESCRIPTION
1	9/15/04	HAB	AKJ	C42345	6/30/05	ARVIND K JOSHI	ISSUED FOR CONSTRUCTION
0	7/20/04	HAB	AKJ	C42345	6/30/05	ARVIND K JOSHI	ISSUED FOR CONSTRUCTION

REVISION DATES (DESIGN STAGE ONLY)

DESIGNED BY H. BULLOCK
DRAWN BY A. GOMEZ
CHECKED BY D. ORTIZ
IN CHARGE A. JOSHI
DATE 04/22/04

REGISTERED PROFESSIONAL ENGINEER — ARVIND K. JOSHI — No. C42345 — Exp. 03/31/06 — CIVIL — STATE OF CALIFORNIA

LOS ANGELES COUNTY METROPOLITAN TRANSPORTATION AUTHORITY
SAN FERNANDO VALLEY EAST-WEST BRT PROJECT

Washington Group International
WASHINGTON GROUP INTERNATIONAL, INC.
5805 SEPULVEDA BLVD., SUITE 500
VAN NUYS, CA 91411

SHIMMICK OBAYASHI, JV
5805 SEPULVEDA BLVD., SUITE 500
VAN NUYS, CA 91411

STREET IMPROVEMENTS GROUP 5
STORM DRAIN PLAN & PROFILE
FULTON AVE. AT BURBANK BLVD.
SHEET 1 OF 2

CONTRACT NO C0675
DRAWING NO G5C6-001 REV 1
SCALE HORIZ. SCALE: 1"=20' VERT. SCALE: 1"=4'
SHEET NO

tim.groom 12/15/2005 04:34:54 PM m:\brt irvine\AS-BUILTS (Merged)\LABOE (WGI)\G5\g5c6-001_AS-BUILT.plt

20' 10' 0 20' 40' HORIZONTAL GRAPHIC SCALE
4' 1' 0 4' 8' VERTICAL GRAPHIC SCALE

SCALES HORIZ. SCALE: 1"=20' VERT. SCALE: 1"=4'
SHEET
INDEX NUMBER

Sheet Version 2.01

THE CITY OF LOS ANGELES OR ITS OFFICERS OR AGENTS SHALL NOT BE RESPONSIBLE FOR THE ACCURACY OR COMPLETENESS OF ELECTRONIC COPIES OF THIS PLAN SHEET.

CITY OF LOS ANGELES DEPARTMENT OF PUBLIC WORKS BUREAU OF ENGINEERING

LA DPW ENGINEERING Standards Present, Sustainable Future

NO.	REVISIONS:	DATE:	BY:
0	ISSUED FOR CONSTRUCTION	7/20/04	HAB
1	ISSUED FOR CONSTRUCTION	3/23/05	HAB
2	AS-BUILT	11/29/05	WJ
	WORK ACCEPTED	SERIAL NO.	

B - PERMITS
BD/BC
INDEX NO.

APPROVALS: DATE: BY:
ST. TREES DIV.
ST. LIGHTING
D.O.T.

CITY ENGINEER
GARY LEE MOORE, P.E. DATE
ACCEPTED BY:
PLAN CHECKER DATE
DIVISION / DISTRICT ENGINEER

VERTICAL CONTROL: NAVD88, 1988 ADJ
HORIZONTAL CONTROL: NAD83, EPOCH 1995.0

SHEET TITLE: PLANS
PROJECT: SAN FERNANDO VALLEY EAST-WEST PROJECT
ADDRESS:

PROJECT NO.
DRAWING NO. 1
SHEET 1 OF 2 SHEETS