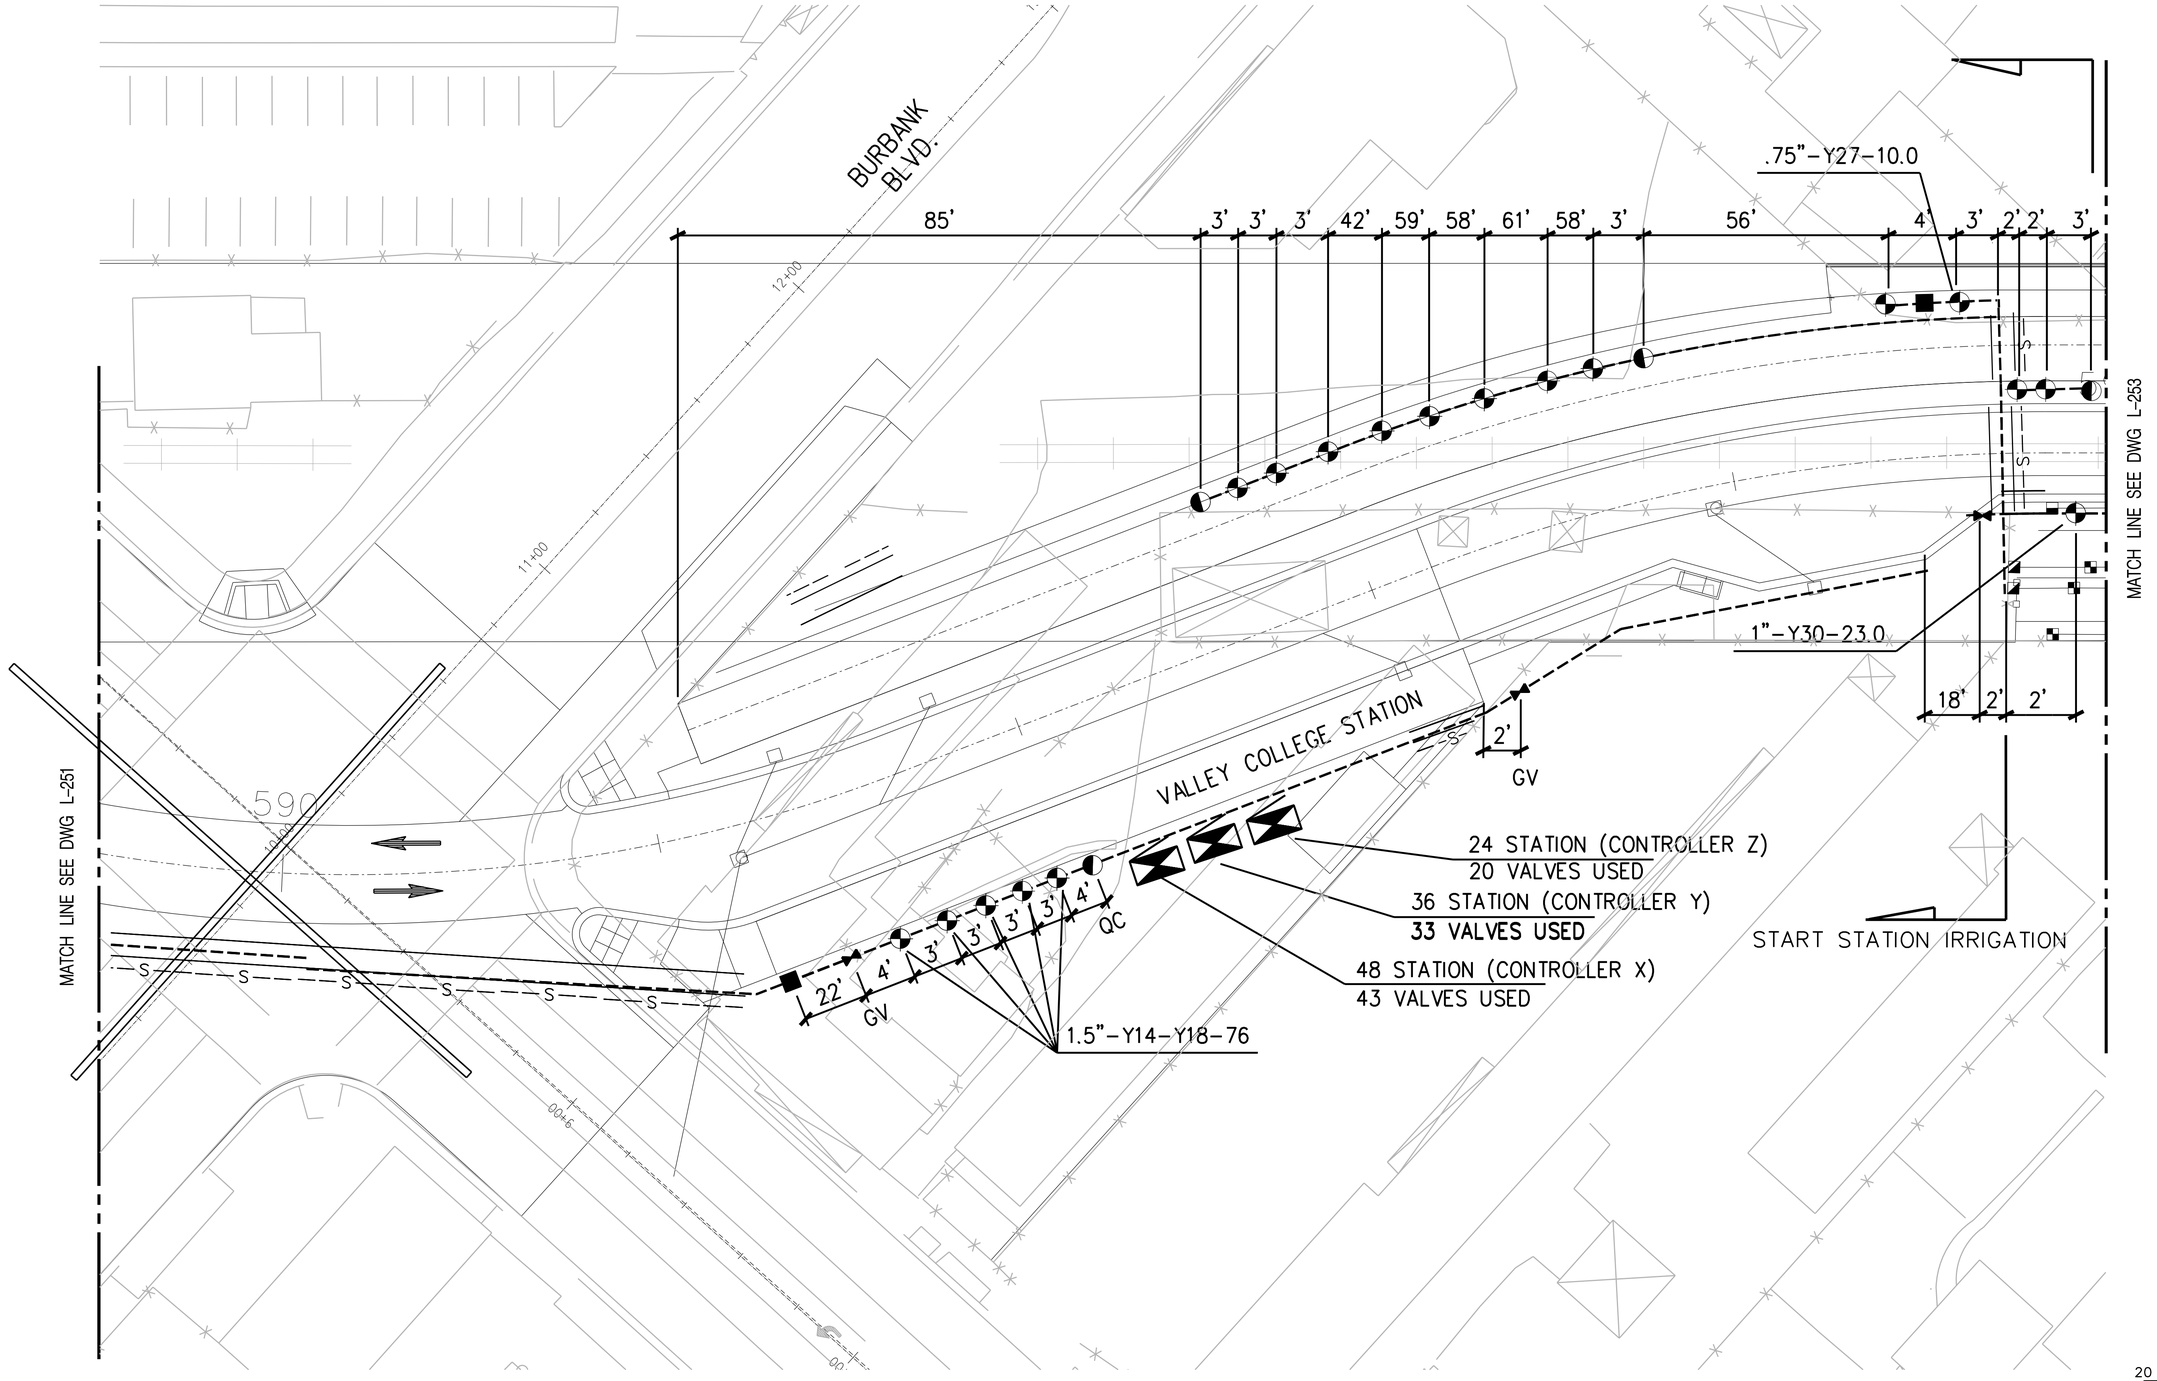


ValleyCrest Landscape Development
AS-BUILT DOCUMENTS

~~ISSUE FOR CONSTRUCTION~~

REV	DATE	BY	APP	REG NO	EXPIRES	SEAL HOLDER	DESCRIPTION
	3/12/08						AS-BUILTS
0	5/23/05						ISSUE FOR CONSTRUCTION

DESIGNED BY MG
DRAWN BY T&P
CHECKED BY KLS
IN CHARGE DT
DATE 5/23/2005

LICENSED LANDSCAPE ARCHITECT — Bryan H. Tatsumi 2653 — Signature — 8-31-06 Renewal Date — 5-23-05 Date — STATE OF CALIFORNIA

LOS ANGELES COUNTY METROPOLITAN TRANSPORTATION AUTHORITY
SAN FERNANDO VALLEY EAST-WEST BRT PROJECT

TATSUMI AND PARTNERS, INC.
LANDSCAPE ARCHITECTURE • PLANNING • DESIGN
5 CORPORATE PARK, SUITE 200 IRVINE, CA 92606-5166
949/250-9990 FAX 949/250-9891

SUBMITTED BY: _____ DATE: _____
DAVID H. TATSUMI

NORTH HOLLYWOOD TO WARNER CENTER
IRRIGATION PLAN
STA 589+50 TO STA 595+00
SHEET 110 OF 136

CONTRACT NO C0675
DRAWING NO L-252 REV 0
SCALE 1"=20'
SHEET NO

$DATE$ $TIME$ $REQUEST$

Mike. G