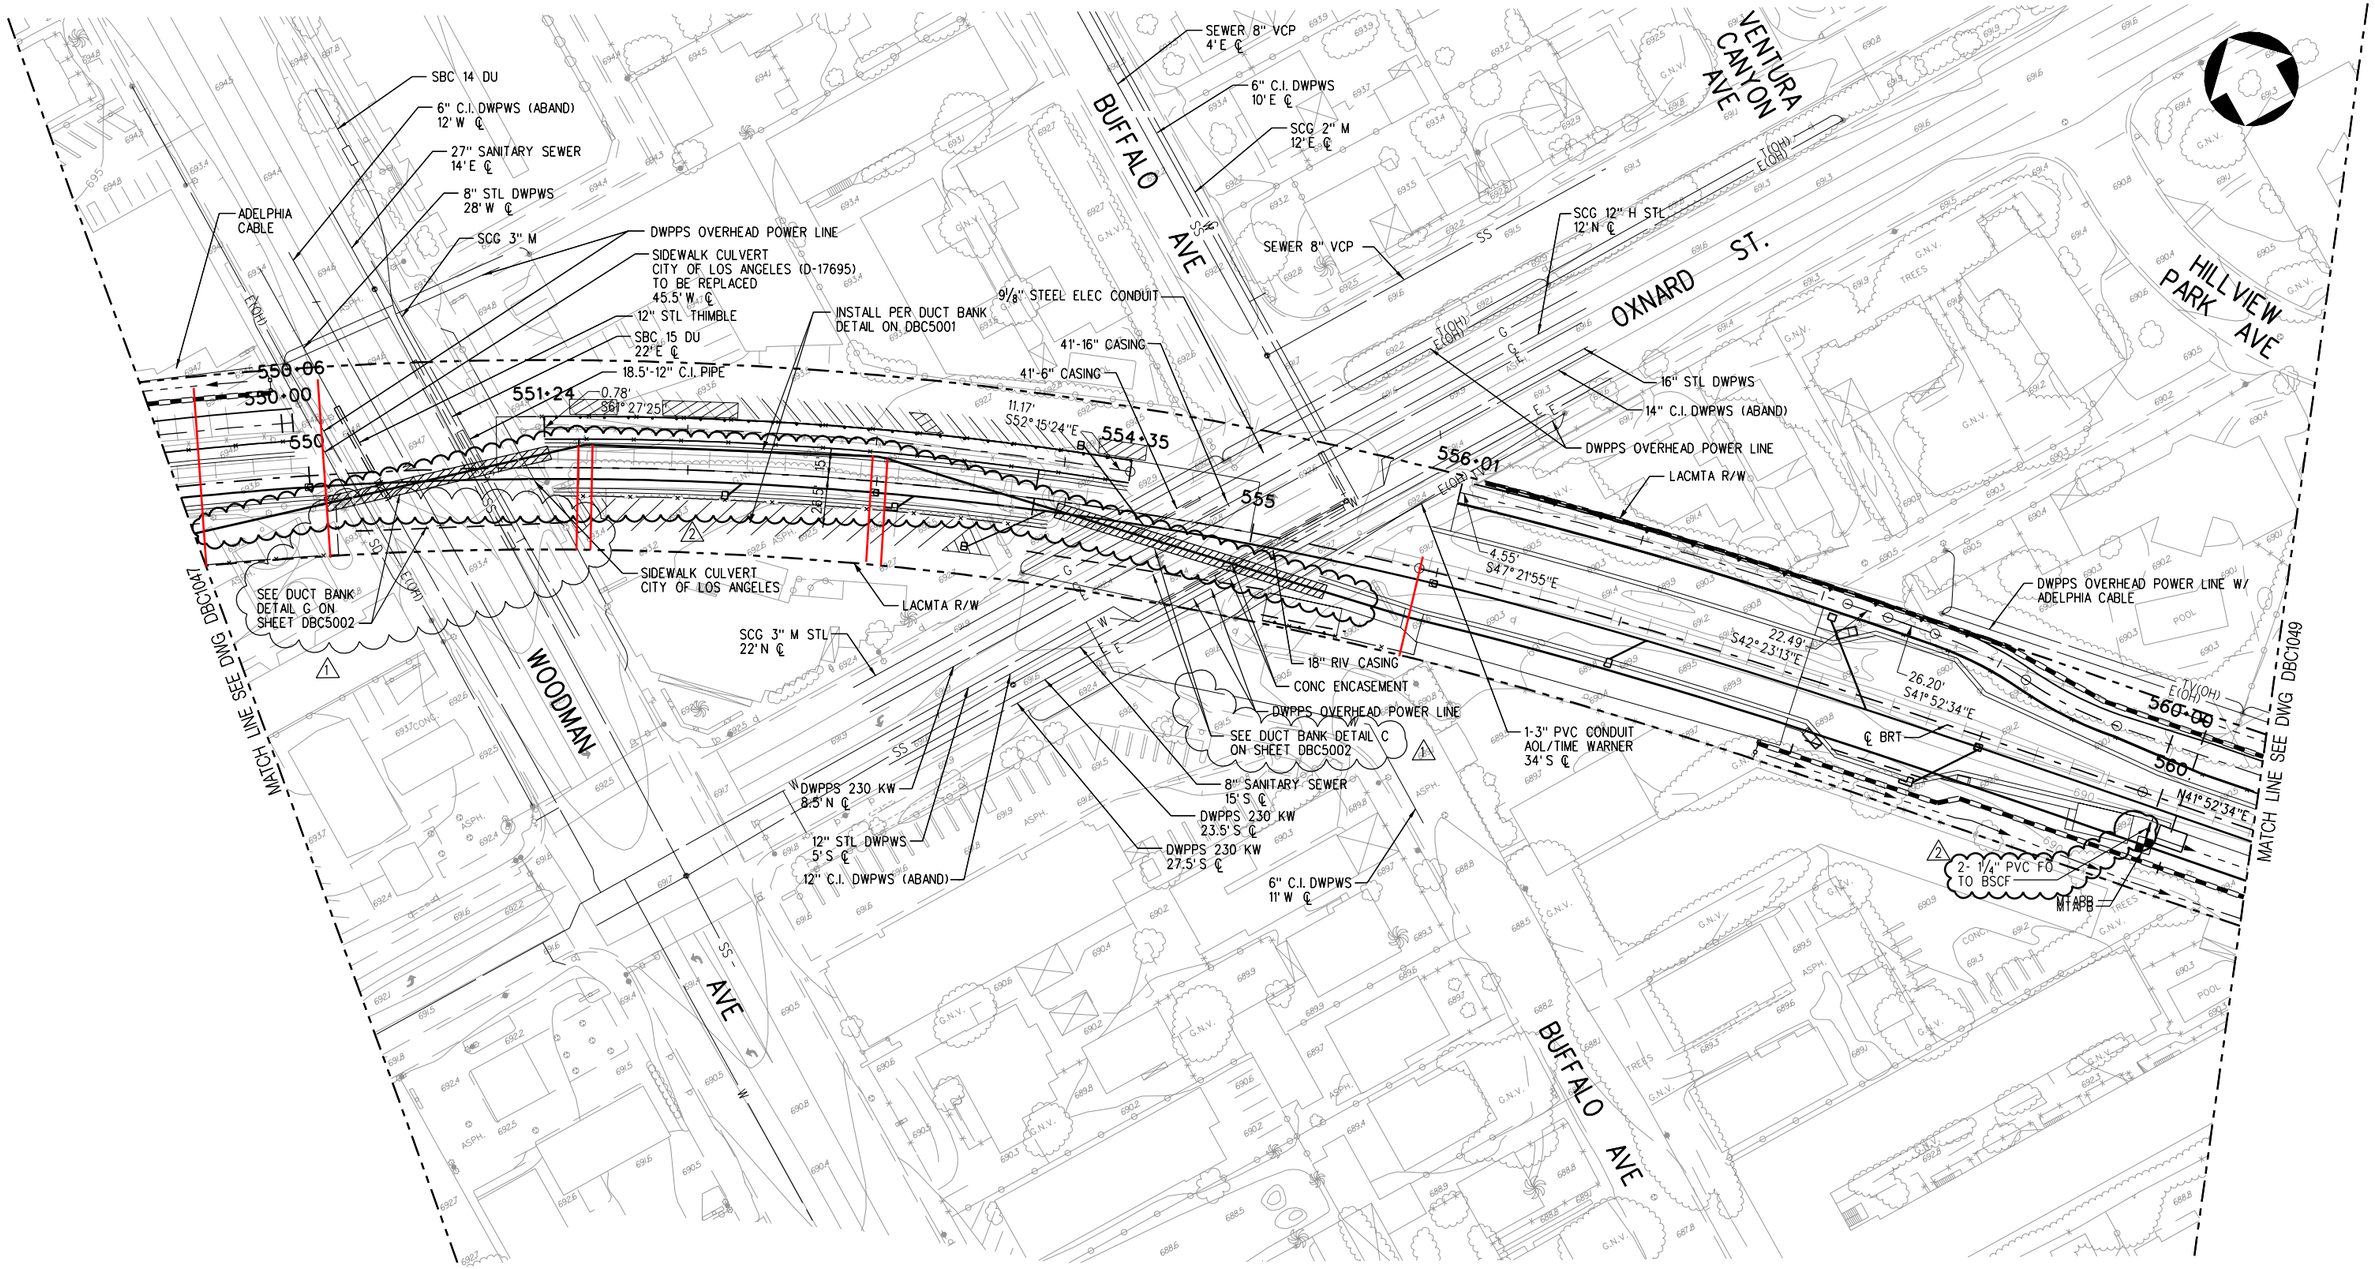

40 20 0 40 80

AS-BUILT RECORD DRAWING

REVIEWED AND APPROVED BY:
GARRY J. JESS - PROJECT MANAGER
WASHINGTON GROUP INTERNATIONAL

REV	DATE	BY	APP	REG NO	EXPIRES	SEAL HOLDER	DESCRIPTION
2	11/23/05	AU	TG				AS-BUILT RECORD DRAWING
1	3/10/04	AKJ	BEJ	C59517	12/31/04	BRETT E. JONES	INCORPORATED MTA COMMENTS - IFC
0	1/22/04	YX	BEJ	C59517	12/31/05	BRETT E. JONES	ISSUED FOR CONSTRUCTION - 1B

DESIGNED BY S. YOUSEFIAN
DRAWN BY A. GOMEZ
CHECKED BY P. ANTICH
IN CHARGE B. JONES
DATE 11/12/03

REGISTERED PROFESSIONAL ENGINEER
BRETT E. JONES
No. C-59517
Exp. 12/31/05
CIVIL
STATE OF CALIFORNIA

LOS ANGELES COUNTY METROPOLITAN TRANSPORTATION AUTHORITY
SAN FERNANDO VALLEY EAST-WEST BRT PROJECT

Washington Group International
WASHINGTON GROUP INTERNATIONAL, INC.
5805 SEPULVEDA BLVD., SUITE 500
VAN NUYS, CA 91411

SHIMMICK OBAYASHI, JV
5805 SEPULVEDA BLVD., SUITE 500
VAN NUYS, CA 91411

NORTH HOLLYWOOD TO WARNER CENTER
MAIN LINE DUCT BANK
STA 549+30 TO STA 560+52

CONTRACT NO C0675
DRAWING NO DBC1048 REV 2
SCALE HORIZ. 1"=40'
SHEET NO

12/15/2005 09:38:28 PM m:\brt irvine\AS-BUILTS (Merged)\MTA (WGI)\DBC\dbc1048_AS-BUILT.plg
tim.groom